MISSISSIPPI DEPARTMENT OF ENVIRONMENTAL QUALITY
Office of Land and Water Resources

P. O. Box 10631
Jackson, MS 39289-0631
WATER WELL DRILLERS LOG

COUNTY WELL LOCATED: Jackson
WELL NUMBER: Ⓓ | CODED: 2480
DATE WELL COMPLETED: 12-13-96

PERMIT NUMBER:
NAME OF DRILLING FIRM: Coast Water Well Service

NAME & MAILING ADDRESS OF LANDOWNER:
Richard Harris
C-Byrd Rd.
Ocean Springs Ms

WELL LOCATION — SEC: 20 TOWNSHIP: 7 (N) (S) RANGE: 7 (E) (W)

DISTANCE: 1/2 Miles DIRECTION: East of NEAREST TOWN: Ocean Springs

OTHER LANDMARK:

WELL PURPOSE: Home, Irrigation, Municipal, Industrial, Fish Pond, etc.

PUMP DATA

PUMP TYPE (Circle One): Submersible, Turbine, Jet, Flowing Well, Other (Describe)

POWER TYPE (Circle One): Electric, Tractor, Diesel, Gasoline, Butane, Other (Describe) H/P 1

Pump Capacity (GPM)	No. of Stages	Setting Depth
7.5	2	FT.

PUMP TEST

Well yielded _____ GPM with a drawdown of _____ ft. after _____ hours of pumping

WELL DATA

Well Depth	Casing Diameter (In.)	Casing Length (Ft.)
468'	2"	458'

Type of Casing	Hole Depth	Depth to Static Water Level
PVC	468'	65'

TYPE OF COMPLETION: (Circle One or More): Gravel Packed, Underreamed, Telescoped, Natural Development, Open Hole, Other (Describe)

WELL GROUTED TO A DEPTH OF 20 FEET
Type Grout (circle one): Cement, Bentonite, or Mix

LOG DATA

TYPE OF LOG RUN (Circle One): No Log Run, Electric, Gamma Ray, Density, Sonic, Neutron, Other (Describe)

Name of Organization Running Log

GEOLOGIC DATA (Office Use Only)

Surface Elev.	Geologic Unit	Unit Thickness	Depth to Top
Subs. SWL	Date	Analysis	Aquifer Test

Driller's Remarks

SCREEN DATA

Diameter - Inches	Length - Feet	Slot Size - Inches
2"	10'	.008

Screen Type	Depth to Bottom - Feet
PVC Saved Sch 80	468

Top of Lap Pipe or Reduction in Casing

IF MORE THAN ONE SCREEN, USE BACK PAGE

DESCRIPTION OF FORMATIONS ENCOUNTERED	FROM	TO
Top Soil	0	2
Blue Clay	2	80
Gray Coarse Sand	80	142
Blue Clay	142	428
Gray Coarse Sand	428	468

IF MORE SPACE IS NEEDED, USE BACK

FORMATIONS (Continued) | FROM | TO

RECEIVED
JAN 13 1997
Dept. of Environmental Quality
Office of Land & Water Resources

If well telescopes please sketch and show depths:

GROUND LEVEL

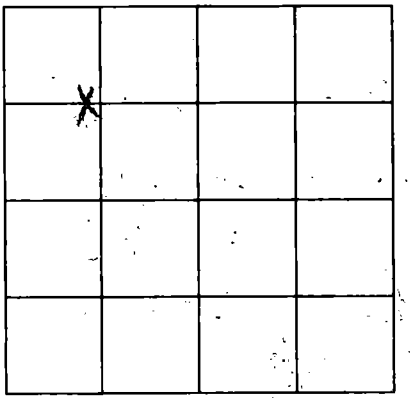

SECTION 20

Please indicate well location X.

ADDITIONAL INFORMATION

If more than one screen, show location of each on sketch.