MISSISSIPPI DEPARTMENT OF ENVIRONMENTAL QUALITY
Office of Land and Water Resources

P. O. Box 10631
Jackson, MS 39289-0631

WATER WELL DRILLERS LOG

COUNTY WELL LOCATED: Jackson

WELL NUMBER: Ø 251.9 CODED

PERMIT NUMBER:

DATE WELL COMPLETED: 4-13-98

NAME OF DRILLING FIRM: Coast Water Well Service

NAME & MAILING ADDRESS OF LANDOWNER: Ms. National Golf Course, Hickory Hills, Gautier Ms

WELL LOCATION: SEC 12 TOWNSHIP 7 (N) RANGE 7 (W)

DISTANCE 3 Miles DIRECTION NORTH of NEAREST TOWN GAUTIER

OTHER LANDMARK:

WELL PURPOSE: Home, Irrigation, Municipal, Industrial, Fish Pond, etc.

PUMP DATA

PUMP TYPE (Circle One): Submersible, Turbine, Jet, Flowing Well, Other (Describe)

POWER TYPE (Circle One): Electric, Tractor, Diesel, Gasoline, Butane, Other (Describe) H/P 2

Pump Capacity (GPM)	No. of Stages	Setting Depth
75	7	60 FT.

PUMP TEST

Well yielded _____ GPM with a drawdown of _____ ft. after _____ hours of pumping

WELL DATA

Well Depth	Casing Diameter (In.)	Casing Length (Ft.)
80'	4"	60'

Type of Casing	Hole Depth	Depth to Static Water Level
PVC	85'	15'

TYPE OF COMPLETION: (Circle One or More): Gravel Packed, Underreamed, Telescoped, Natural Development, Open Hole, Other (Describe)

WELL GROUTED TO A DEPTH OF 20 FEET
Type Grout (circle one): Cement, Bentonite, or Mix

LOG DATA

TYPE OF LOG RUN (Circle One): No Log Run, Electric, Gamma Ray, Density, Sonic, Neutron, Other (Describe)

Name of Organization Running Log

GEOLOGIC DATA (Office Use Only)

Surface Elev.	Geologic Unit	Unit Thickness	Depth to Top
Subs. SWL	Date	Analysis	Aquifer Test

Driller's Remarks

07-30-98A09:45 RCVD

Top of Lap Pipe or Reduction in Casing FEET

IF TELESCOPED OR MORE THAN ONE SCREEN: USE BACK PAGE

SCREEN DATA

Diameter - Inches	Length - Feet	Slot Size - Inches
4"	20'	.008

Screen Type	Depth to Bottom - Feet
PVC	80'

DESCRIPTION OF FORMATIONS ENCOUNTERED	FROM	TO
Top Soil	0	2
Gray Red Black Clay	2	18
Fine Sand	18	25
Black Clay	25	45
Med Sand	45	85

FORMATIONS (Continued)	FROM	TO

IF MORE SPACE IS NEEDED, USE BACK

If well telescopes please sketch and show depths.

GROUND LEVEL

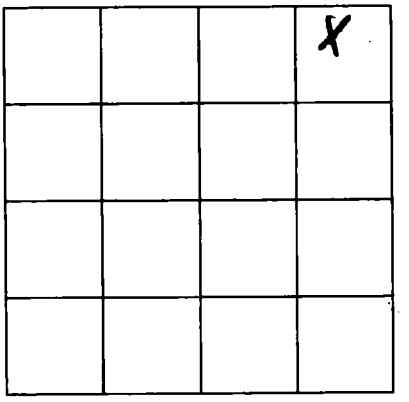

SECTION 12

Please indicate well location X.

ADDITIONAL INFORMATION

If more than one screen, show location of each on sketch.