MISSISSIPPI DEPARTMENT OF ENVIRONMENTAL QUALITY
Office of Land and Water Resources

P. O. Box 10631
Jackson, MS 39289-0631
WATER WELL DRILLERS LOG

COUNTY WELL LOCATED: Jackson	PERMIT NUMBER
WELL NUMBER: 02548 CODED	NAME OF DRILLING FIRM: Coast Waterwell Service
DATE WELL COMPLETED: 7-7-99	

NAME & MAILING ADDRESS OF LANDOWNER
Henry Ladnier
Old Spanish Trail
Ocean Springs Ms.

WELL LOCATION SEC	TOWNSHIP	RANGE
32	7 N (S)	1 E W

DISTANCE	DIRECTION	NEAREST TOWN
3 Miles	WEST of	GAUTIER

OTHER LANDMARK

WELL PURPOSE: (Home) Irrigation, Municipal, Industrial, Fish Pond, etc.

PUMP DATA

PUMP TYPE (Circle One): Submersible, Turbine, (Jet) Flowing Well, Other (Describe) _____

POWER TYPE (Circle One): (Electric) Tractor, Diesel, Gasoline, Butane, Other (Describe) _____ H/P 2

Pump Capacity (GPM)	No. of Stages	Setting Depth
10	3	FT.

PUMP TEST

Well yielded _____ GPM with a drawdown of _____ ft. after _____ hours of pumping

WELL DATA

Well Depth	Casing Diameter (In.)	Casing Length (Ft.)
505'	2"	495'

Type of Casing	Hole Depth	Depth to Static Water Level
PVC	505'	75'

TYPE OF COMPLETION: (Circle One or More): Gravel Packed, Underreamed, Telescoped, (Natural Development) Open Hole, Other (Describe) _____

WELL GROUTED TO A DEPTH OF 20 FEET
Type Grout (circle one): Cement, (Bentonite) or Mix

LOG DATA

TYPE OF LOG RUN (Circle One): (No Log Run) Electric, Gamma Ray, Density, Sonic, Neutron, Other (Describe) _____

Name of Organization Running Log

GEOLOGIC DATA (Office Use Only)

Surface Elev.	Geologic Unit	Unit Thickness	Depth to Top
Subs. SWL	Date	Analysis	Aquifer Test

Driller's Remarks

SCREEN DATA

Diameter - Inches	Length - Feet	Slot Size - Inches
2"	10'	.004

Screen Type	Depth to Bottom - Feet
PVC Wrapped	505'

Top of Lap Pipe or Reduction in Casing
FEET

IF TELESCOPED OR MORE THAN ONE SCREEN: USE BACK PAGE

DESCRIPTION OF FORMATIONS ENCOUNTERED	FROM	TO	FORMATIONS (Continued)	FROM	TO
Top Soil	0	2			
White Coarse Sand	2	50			
Blue Clay	50	125			
Medium Gray Sand	125	170			
Blue Clay Streaks of Sand	170	470			
Medium Gray Sand	470	505			
			IF MORE SPACE IS NEEDED, USE BACK		

If well telescopes please sketch and show depths.

GROUND LEVEL

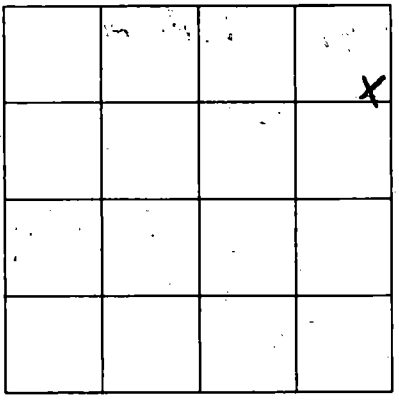

SECTION 32

Please indicate well location X.

ADDITIONAL INFORMATION

If more than one screen, show location of each on sketch.