MISSISSIPPI DEPARTMENT OF ENVIRONMENTAL QUALITY
Office of Land and Water Resources

P. O. Box 10631
Jackson, MS 39289-0631

WATER WELL DRILLERS LOG

COUNTY WELL LOCATED	Jackson
WELL NUMBER	04-2541
CODED	
PERMIT NUMBER	
NAME OF DRILLING FIRM	Coast Water Well Service
DATE WELL COMPLETED	2-24-00

NAME & MAILING ADDRESS OF LANDOWNER: Ronald Wheat, Brown Rd., Ocean Springs Ms

WELL LOCATION: SEC 29 TOWNSHIP 7 (N) (S) RANGE 7 (E) (W)

DISTANCE 2 1/2 Miles DIRECTION EAST of NEAREST TOWN Ocean Springs

OTHER LANDMARK:

WELL PURPOSE: (Home) Irrigation, Municipal, Industrial, Fish Pond, etc.

PUMP DATA

PUMP TYPE (Circle One): Submersible, Turbine, (Jet) Flowing Well, Other (Describe)

POWER TYPE (Circle One): (Electric) Tractor, Diesel, Gasoline, Butane, Other (Describe) H/P 1

Pump Capacity (GPM)	No of Stages	Setting Depth
8	2	FT.

PUMP TEST

Well yielded _____ GPM with a drawdown of _____ ft. after _____ hours of pumping

WELL DATA

Well Depth	Casing Diameter (In.)	Casing Length (Ft.)
710'	2"	700'

Type of Casing	Hole Depth	Depth to Static Water Level
PVC	710'	55'

TYPE OF COMPLETION: (Circle One or More): Gravel Packed, Underreamed, Telescoped, (Natural Development), Open Hole, Other (Describe)

WELL GROUTED TO A DEPTH OF 20 FEET
Type Grout (circle one): Cement, (Bentonite), or Mix

LOG DATA

TYPE OF LOG RUN (Circle One): (No Log Run) Electric, Gamma Ray, Density, Sonic, Neutron, Other (Describe)

Name of Organization Running Log

GEOLOGIC DATA (Office Use Only)

Surface Elev	Geologic Unit	Unit Thickness	Depth to Top
Subs SWL	Date	Analysis	Aquifer Test

Driller's Remarks

Top of Lap Pipe of Production Casing _____ FEET

IF TELESCOPED OR OVER THAN ONE SCREEN: USE BACK PAGE

SCREEN DATA

Diameter - Inches	Length - Feet	Slot Size - Inches
2"	10'	.008

Screen Type	Depth to Bottom - Feet
PVC	710'

RECEIVED
JUN 09 2000
Dept. of Environmental Quality
Office of Land & Water Resources

DESCRIPTION OF FORMATIONS ENCOUNTERED	FROM	TO
Top Soil	0	2
Brown Clay	2	20
White Coarse sand	20	45
Blue Clay	45	110
Med gray sand	110	150
Blue Clay w/ sand	150	625
gray Coarse sand	625	710

FORMATIONS (Continued)	FROM	TO

IF MORE SPACE IS NEEDED, USE BACK

If well telescopes please sketch and show depths.

GROUND LEVEL

RECEIVED
JUN 0 3 2010
Dept. of Environmental Quality
Office of Land & Water Resources

If more than one screen, show location of each on sketch.

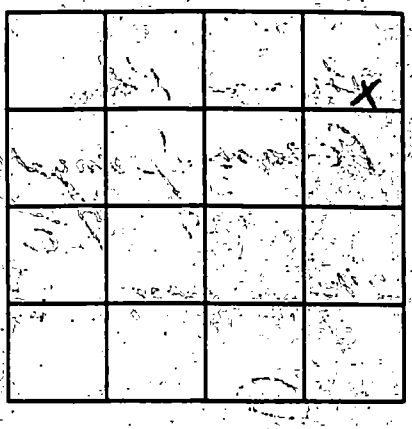

SECTION 29

Please indicate well location X.

ADDITIONAL INFORMATION