

JACKSON

P 168

WATER WELL DRILLERS LOG



Date: 1-14-61, 1961, Driller: Colville Water Supply Co County JACKSON
 (Name)

(1) Owner of Land: BA Turner
 (Name)
Gautier Miss
 (Address)

(2) Location: NW 1/4, SW 1/4, Sec. 3 T7SR6W
7 miles NN of Gautier
 (distance) (direction) (Nearest Town)

(3) Topography: (Level) (Flat) (Hilly)

(4) Purpose of Well: (Domestic Irrigation) (Municipal, Industrial, Other)

Description & Color of Materials Sand, Clay, Red Clay, Shell, etc.	Thick- ness Feet	Depth Feet
<u>0 yellow clay</u>	<u>10</u>	<u>Fine Sand</u>
<u>21 "</u>	<u>3 sand</u>	<u>42 "</u>
<u>13 Sand</u>	<u>82</u>	<u>72</u>

Depth Form depth Form


Information upon completion of well:

- (1) Diameter 1 1/4 inches.
- (2) Total Depth 82 feet.
- (3) Water Level 14 feet below top of ground.
- (4) Cased to _____, Size _____
- (5) Screen: Size 1 1/4, Length 5 ft
- (6) Were any formations sealed against pollution?
 _____ yes, _____ no.

If YES depth of formation _____

Why _____

Drillers Remarks: _____

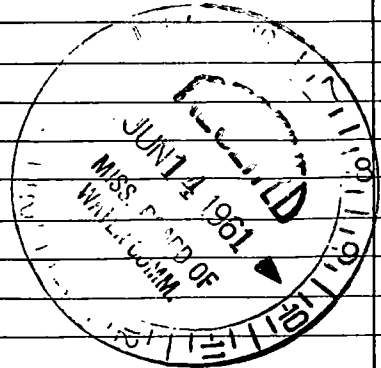

(Use Back Side)

Well No. 27




