

JACKSON MISSISSIPPI BOARD OF WATER COMMISSIONERS

P 192


4-19-62

WATER WELL DRILLERS LOG

Date: 4/19, 1962, Driller: COLVILLE County JACKSON
 49 (Name)

	Description & Color of Materials Sand, Clay, Red Clay, Shell, etc.	Thick- ness Feet	Depth Feet
(1) Owner of Land: <u>John Dupont</u> (Name) <u>Escatawpa</u> (Address)			
(2) Location: <u>NE 1/4, SE 1/4, Sec. 11 T.78R.L.11</u> _____ miles _____ of _____ (distance) (direction) (Nearest Town)			
(3) Topography: _____ (Hilly) (Flat) (Level) <input checked="" type="checkbox"/>			
(4) Purpose of Well: <u>Domestic</u> (Domestic Irrigation Municipal, Industrial, Other)			
Information upon completion of well:			
(1) Diameter <u>1 1/4</u> inches.			
(2) Total Depth <u>336</u> feet.			
(3) Water Level <u>4'-2"</u> feet below top of ground.			
(4) Cased to _____, Size _____			
(5) Screen: Size <u>1 1/4</u> , Length <u>10</u>			
(6) Were any formations sealed against pollution? _____ yes, _____ no. <input checked="" type="checkbox"/>			
If YES depth of formation _____			
Why _____			
Drillers Remarks: _____ _____ _____ _____ _____			

Depth	Form	Depth	Form
0	CLAY	15	SAND
46	CLAY	50	SAND
70	CLAY	76	SAND
95	CLAY	130	SAND
180	CLAY	315	SAND
336	T.D.		

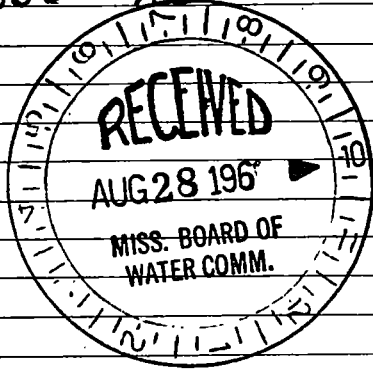

Well No. 130

(Use Back Side)










