Jackson
P 309
10-15-69

# MISSISSIPPI
# BOARD OF WATER COMMISSIONERS
416 North State Street
Jackson, Mississippi 39201

CODED

## WATER WELL DRILLERS LOG

Oct 15 1959 Rebville Water Supply Jackson
date well completed — firm name — county well located

LANDOWNER: N. L. Booker
Kosciatawpa
(mailing address)

WELL LOCATION:
sec. 12 T 7 N (S) R 6 E (W)
¾ (distance) miles North (direction) of MP (nearest town)

WELL PURPOSE: home
(home, irrigation, municipal, industrial)

WELL COMPLETION DATA:

(1) diameter (inches) 1¼
(2) total depth (feet) 609
(3) static water level (feet) 3.95 below/above top of ground.
(4) casing Galv (material), _____ (depth),
_____ (size) If telescope see back.
(5) screen 20 (length), 589 (depth to top)
1¼ (size), stainless (material)
(6) pump _____ (HP) _____ (yield gpm)
_____ (type power)
(7) electric log no (yes or no)
_____ (organization running log)
(8) how well bottom plugged BP Valve

DRILLERS REMARKS: pump installed by owner

| description of formations encountered | from | to |
|---|---|---|
| Clay | 0 | 42 |
| sand and gravel | 42 | 105 |
| clay | 105 | 126 |
| sand | 126 | 180 |
| Clay | 180 | 567 |
| fine sand | 567 | 588 |
| sand | 588 | 609 |

JAN 1970

If well telescopes please sketch and show depths.

GROUND LEVEL

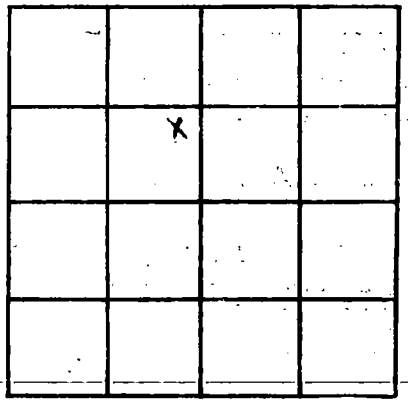


SECTION 12

Please indicate well location X.

ADDITIONAL INFORMATION

If more than one screen, show locations of each on sketch.