JACKSON
P 319
8-7-70

MISSISSIPPI
BOARD OF WATER COMMISSIONERS
416 North State Street
Jackson, Mississippi 39201

CODED

# WATER WELL DRILLERS LOG

Aug 7 1970 Cobb Water Supply Jackson
date well completed — firm name — county well located

LANDOWNER: Mrs. H. G. Fredrick
Gautier Miss.
(mailing address)

WELL LOCATION:
sec. 31 T 7 N R 6 E
8 miles West of Pascagoula
(distance) (direction) (nearest town)

WELL PURPOSE: home
(home, irrigation, municipal, industrial)

WELL COMPLETION DATA:

(1) diameter (inches) 2
(2) total depth (feet) 299
(3) static water level (feet) 19 below above top of ground.
(4) casing galv (material), 294 (depth), ____ (size) if telescope see back.
(5) screen 5 (length), 294 (depth to top) 2 (size), stainless (material)
(6) pump 3/4 (HP) 8 (yield gpm) elec (type power)
(7) electric log no (yes or no)
(organization running log)
(8) how well bottom plugged BP Jetty

| description of formations encountered | from | to |
|---|---|---|
| clay | 0 | 26 |
| sand | 26 | 75 |
| clay | 75 | 98 |
| sand | 98 | 173 |
| clay | 173 | 194 |
| sand | 194 | 299 |

CODED

SEP 11 1970
MISS. BD. OF WATER COMM.

DRILLERS REMARKS:

If well telescopes please sketch and show depths.

GROUND LEVEL

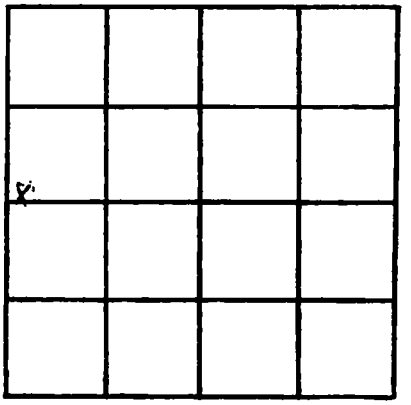


SECTION _____

Please indicate well location X.

ADDITIONAL INFORMATION

If more than one screen, show locations of each on sketch.