Jackson
P 2068

6-24-80

MISSISSIPPI
BOARD OF WATER COMMISSIONERS
416 North State Street
Jackson, Mississippi 39201

WATER WELL DRILLERS LOG

MAR 1981 RECEIVED

6-24-80 19 Coast Water Well Service Inc. Jackson
date well completed — firm name — county well located

LANDOWNER: Walter Shaw
1625 Pat Drive
Gautier, Miss
(mailing address) 39553

WELL LOCATION:
LG. sec. 2 T 8 (S) R 6 (W)
In (distance) miles (direction) of Gautier (nearest town)

WELL PURPOSE: (home, irrigation, municipal, industrial)

WELL COMPLETION DATA:

(1) diameter (inches) well 2"
(2) total depth (feet) well 300'
(3) static water level (feet) 26' below above top of ground.
(4) casing P.V.C. (material), 290' (depth), CL
2" (size) If telescope see back.
(5) screen 10' (length), 290' (depth to top)
2" (size), P.V.C. (material)
(6) pump 1 (HP) 16 (yield gpm)
elec (type power)
(7) electric log No (yes or no)
(organization running log)
(8) how well bottom plugged Backwash valve

DRILLERS REMARKS:

description of formations encountered	from	to
Top Soil	0	3
Red Clay	3	10
Blue Clay	10	50
Gray Coarse Sand	50	80
Gray Coarse Sand + wood	80	87
Gray Coarse	87	114
Blue Clay + Streak of Sand	114	123
Blue Clay	123	193
Blue Clay + Streak of Sand	193	210
Gray Coarse Sand	210	300
		Hole

DEPT. OF NATURAL RESOURCES
BUREAU OF LAND & WATER RESOURCES
MAR 20 1981
RECEIVED

If well telescopes please sketch and show depths.

GROUND LEVEL

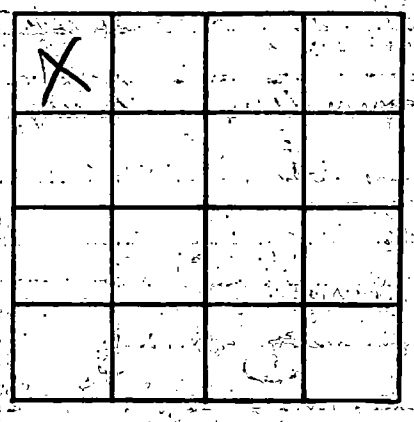

L.G. 2
SECTION

Please indicate well location X.

ADDITIONAL INFORMATION

If more than one screen, show locations of each on sketch.