Jackson
P2403

MISSISSIPPI DEPARTMENT OF NATURAL RESOURCES

Bureau of Land and Water Resources
Southport Mall
P.O. Box 10631
Jackson, Mississippi 39209

WATER WELL DRILLERS LOG

9-22- 1983 Cross Water Well Ser. Jackson
date well completed — firm name — county well located

LANDOWNER: Maggie Prock
3204 Oak St.
Gautier, Miss.
(mailing address) 39553

WELL LOCATION:
sec. 8 T 7 S R 6 E
1N (distance) miles (direction) of GAUTIER (nearest town)

WELL PURPOSE: Home
(home, irrigation, municipal, industrial)

WELL COMPLETION DATA:

(1) diameter (inches) 2"
(2) total depth (feet) 430'
(3) static water level (feet) 64' below ~~above~~ top of ground.
(4) casing PVC (material), 410' (depth), ____ (size) If telescope see back.
(5) screen 20' (length), 410' (depth to top) 2" (size), PVC (material)
(6) pump 1 h.p. (HP) 7 (yield gpm) Elect. (type power)
(7) electric log No. (yes or no) ____ (organization running log)
(8) How well bottom plugged Check Wash Valve

DRILLERS REMARKS:

description of formations encountered	from	to
Top soil	0	5'
Red Clay	5'	15'
Blue Clay	15'	63'
White Coarse sand & gravel	63'	110'
Blue Clay	110'	200'
Gray Coarse sand	200'	293'
Blue Clay	293'	322'
Blue Clay & Streak of sand	322'	365'
Blue Clay	365'	387'
Gray fine sand	387'	420'
Blue Clay	420'	430'

DEPT. OF NATURAL RESOURCES
BUREAU OF LAND & WATER RESOURCES
OCT 1 1983
RECEIVED

If well telescopes please sketch and show depths.

GROUND LEVEL

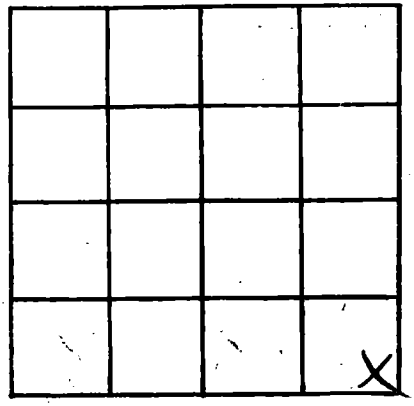

SECTION 8

Please indicate well location X.

ADDITIONAL INFORMATION

If more than one screen, show locations of each on sketch.