JACKSON
P 7121

MISSISSIPPI DEPARTMENT OF NATURAL RESOURCES

Bureau of Land and Water Resources
Southport Mall
P.O. Box 10631
Jackson, Mississippi 39209

WATER WELL DRILLERS LOG

5-22-85 19 Coast Water Well Serv. Jackson
date well completed — firm name — county well located

LANDOWNER: Pickens Garden Center
624 Old Spanish Trail
Gautier, MS 39553
(mailing address)

WELL LOCATION:
sec. 2 T 8 N (S) R 6 E (W)
1N miles — of GAUTIER
(distance) (direction) (nearest town)

WELL PURPOSE:
(home, irrigation, municipal, industrial)

WELL COMPLETION DATA:
(1) diameter (inches) 2"
(2) total depth (feet) 300'
(3) static water level (feet) 20' below above top of ground.
(4) casing PVC (material), 290' (depth),
2" (size) If telescope see back.
(5) screen 10' (length), 290' (depth to top)
2" (size), PVC (material)
(6) pump H.P. (HP) 13 (yield gpm)
Elect. (type power)
(7) electric log No (yes or no)
— (organization running log)
(8) how well bottom plugged Rock Wool Value

DRILLERS REMARKS:

description of formations encountered	from	to
Top soil	0	3'
Red Clay	3'	31'
Rock	—	31'
Red Med. sand	31'	75'
Red Coarse sand	75'	100'
Blue Clay	100'	135'
White Coarse sand	135'	158'
Blue Clay	158'	200'
Gray Coarse sand	200'	295'
Gray Coarse sand & gravel	295'	300'
5'-2" Tail Pipe		

RECEIVED
JUL 10 1985
Department of Natural Resources
Bureau of Land & Water Res...

If well telescopes please sketch and show depths.

GROUND LEVEL

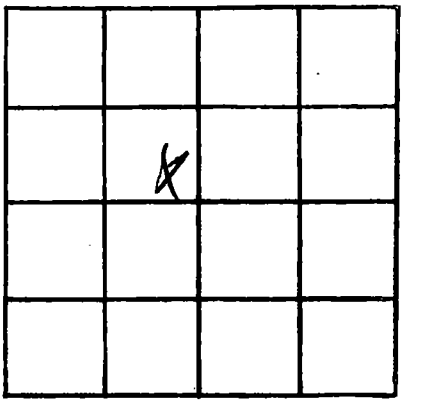

SECTION 2

Please indicate well location X.

ADDITIONAL INFORMATION

If more than one screen, show locations of each on sketch.