Jackson
Q 311
1-30-68

CODED

MISSISSIPPI
BOARD OF WATER COMMISSIONERS
416 North State Street
Jackson, Mississippi 39201

WATER WELL DRILLERS LOG

Jan 30 1968 Cobville Water Sup Jackson
date well completed — firm name — county well located

LANDOWNER: Marion Brown

Pearl Miss
(mailing address)

WELL LOCATION:
sec. 7 T 7 N (S) R 4 E (W)

6 miles east of MD
(distance) (direction) (nearest town)

WELL PURPOSE: home
(home, irrigation, municipal, industrial)

WELL COMPLETION DATA:

(1) diameter (inches) 2

(2) total depth (feet) 132

(3) static water level (feet) 5 below/above top of ground.

(4) casing galv (material), ____ (depth),

____ (size) if telescope see back.

(5) screen 5 (length), 127 (depth to top)

2 (size), stainless (material)

(6) pump ____ (HP) ____ (yield gpm)

____ (type power)

(7) electric log no (yes or no)

____ (organization running log)

(8) how well bottom plugged BP Cabr

DRILLERS REMARKS: Pump installed by owner

description of formations encountered	from	to
Soft blue clay	0	40
sand	40	66
clay	66	100
sand	100	132

APR 21 1969
MISS. BD. OF WATER COMM.

If well telescopes please sketch and show depths.

GROUND LEVEL

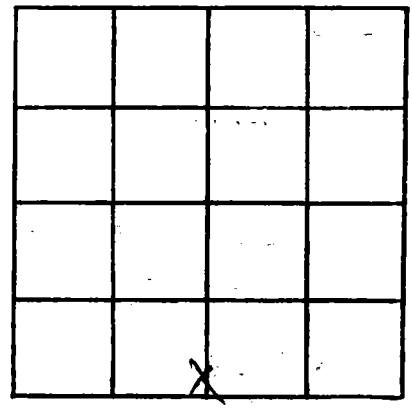

SECTION 7

Please indicate well location X.

ADDITIONAL INFORMATION

If more than one screen, show locations of each on sketch.