Jackson
Q314
2-11-69

CODED

MISSISSIPPI
BOARD OF WATER COMMISSIONERS
416 North State Street
Jackson, Mississippi 39201

WATER WELL DRILLERS LOG

Feb 11 1969 — date well completed
L. L. Garland — firm name
Jackson — county well located

LANDOWNER: A. L. Stokes
Pascagoula, Miss
Old Hiway #90
(mailing address)

WELL LOCATION:
sec. 13 T 7 N (S) R 5 E (W)
3 miles (distance) East (direction) of Pascagoula (nearest town)

WELL PURPOSE: Home
(home, irrigation, municipal, industrial)

WELL COMPLETION DATA:

(1) diameter (inches) 2
(2) total depth (feet) 515
(3) static water level (feet) 3 below / above top of ground.
(4) casing steel (material), 505 (depth),
_____ (size) If telescope see back.
(5) screen 10 (length), 505 (depth to top)
2 (size), stainless steel (material)
(6) pump Customer installed (HP) (yield gpm)
Pump & own (type power)
(7) electric log no (yes or no)
_____ (organization running log)
(8) how well bottom plugged w. Valve

DRILLERS REMARKS:
58 ft water sand
Amber Colored Water

description of formations encountered	from	to

CODED

FEB 25 19[illegible]
MISS. BD. OF WATER [illegible]

If well telescopes please sketch and show depths.

GROUND LEVEL

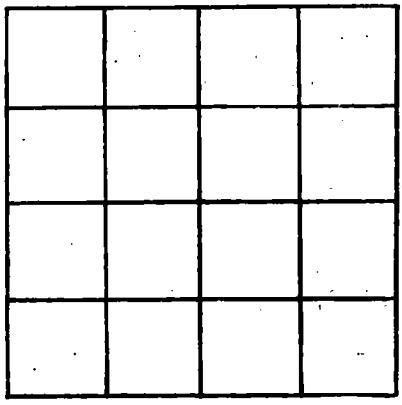

SECTION 13

Please indicate well location X.

ADDITIONAL INFORMATION

If more than one screen, show locations of each on sketch.