JACKSON
Q 361
1-21-72

MISSISSIPPI
BOARD OF [illegible] COMMISSIONERS
416 North [illegible] Street
Jackson, Mississippi 39201

CODED

MAR 22 1972

WATER WELL DRILLERS LOG

1-21 1972 Coast Water Well Co. Jackson
date well completed — firm name — county well located

LANDOWNER: Charles Crosby
3008 Brown St.
Moss Point Miss.
(mailing address)

WELL LOCATION:
sec. 13 T 7 (S) R 5 (W)
4 (distance) miles East (direction) of Moss Point (nearest town)

WELL PURPOSE: Restaurant
(home, irrigation, municipal, industrial)

WELL COMPLETION DATA:

(1) diameter (inches) 2"
(2) total depth (feet) 241
(3) static water level (feet) 30 below ~~above~~ top of ground.
(4) casing galv. (material), 231' (depth), 2" (size) if telescope see back.
(5) screen 10' (length), 231' (depth to top), 2" (size), stainless bahug (material)
(6) pump ~~hp~~ (HP), 8 (yield gpm)
elec (type power)
(7) electric log No (yes or no)
(organization running log)
(8) how well bottom plugged Back wash valve

DRILLERS REMARKS:

description of formations encountered	from	to
top soil	0	21
coarse sand & gravel	21	55
blue clay	55	115
sand - fine to med.	115	241

CODED

If well telescopes please sketch and show depths.

GROUND LEVEL

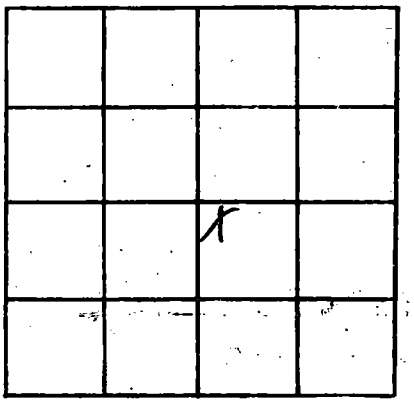

SECTION 13

Please indicate well location X.

ADDITIONAL INFORMATION

If more than one screen, show locations of each on sketch.