JACKSON
Q 370
8-10-72

MISSISSIPPI
BOARD OF WATER COMMISSIONERS
416 North State Street
Jackson, Mississippi 39201

CODED

WATER WELL DRILLERS LOG

Aug. 10 1972 B Colville Well Co. Jackson Hinds
date well completed — firm name — county well located

LANDOWNER: A. L. Mabatthy
Jr. Kreole Miss.
(mailing address)

WELL LOCATION:
sec 22 T 7S (S) R 5W (W)
2 1/2 miles E of Mas Pud
(distance) (direction) (nearest town)

WELL PURPOSE: home
(home, irrigation, municipal, industrial)

WELL COMPLETION DATA:

(1) diameter (inches) 2"
(2) total depth (feet) 257
(3) static water level (feet) -40 (below) (above) top of ground.
(4) casing 2" (material), 252 (depth),
(size) If telescope see back.
(5) screen 5' (length), 252 (depth to top)
2" (size), Stainless (material)
(6) pump 1 (HP) 15 (yield gpm)
elec (type power)
(7) electric log No (yes or no)
(organization running log)
(8) how well bottom plugged B.P. Value

DRILLERS REMARKS:

description of formations encountered	from	to
Sand	0	30
Clay	30	100
Sand	100	120
Clay	120	216
Sand	216	258

CODED

SEP 28 1972
MISS. BD. OF WATER COMM

If well telescopes please sketch and show depths.

GROUND LEVEL

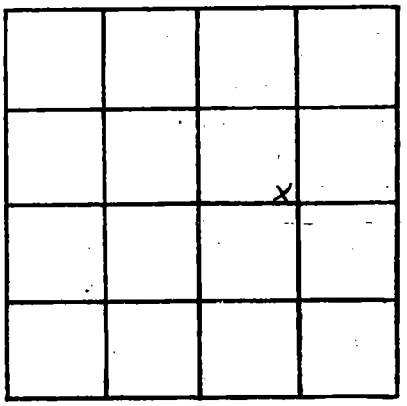

SECTION 22

Please indicate well location X.

ADDITIONAL INFORMATION

If more than one screen, show locations of each on sketch.