MISSISSIPPI DEPARTMENT OF ENVIRONMENTAL QUALITY
Office of Land and Water Resources

P. O. Box 10631
Jackson, MS 39289-0631
WATER WELL DRILLERS LOG

COUNTY WELL LOCATED: Jackson	PERMIT NUMBER:
WELL NUMBER: Q532 / CODED:	NAME OF DRILLING FIRM: Coast Water Well Service
DATE WELL COMPLETED: 6-21-96	

NAME & MAILING ADDRESS OF LANDOWNER
Robert McCormick
Cobia Rd.
Pascagoula, Ms

WELL LOCATION: SEC 23 TOWNSHIP 7 ~~N~~ (S) RANGE 5 ~~E~~ (W)

DISTANCE 1 Miles DIRECTION EAST of NEAREST TOWN Moss Point

OTHER LANDMARK:

WELL PURPOSE: (Home), Irrigation, Municipal, Industrial, Fish Pond, etc.

PUMP DATA

PUMP TYPE (Circle One): Submersible, Turbine, (Jet), Flowing Well, Other (Describe) ____

POWER TYPE (Circle One): (Electric), Tractor, Diesel, Gasoline, Butane, Other (Describe) ____ H/P 1

Pump Capacity (GPM)	No. of Stages	Setting Depth
11	2	FT.

PUMP TEST

Well yielded ____ GPM with a drawdown of ____ ft. after ____ hours of pumping

WELL DATA

Well Depth	Casing Diameter (In.)	Casing Length (Ft.)
230'	2"	220'
Type of Casing	**Hole Depth**	**Depth to Static Water Level**
PVC	230'	21'

TYPE OF COMPLETION: (Circle One or More): Gravel Packed, Underreamed, Telescoped, (Natural Development), Open Hole, Other (Describe) ____

WELL GROUTED TO A DEPTH OF 20 FEET
Type Grout (circle one): Cement, (Bentonite), or Mix

LOG DATA

TYPE OF LOG RUN (Circle One): (No Log Run), Electric, Gamma Ray, Density, Sonic, Neutron, Other (Describe) ____

Name of Organization Running Log

GEOLOGIC DATA (Office Use Only)

Surface Elev.	Geologic Unit	Unit Thickness	Depth to Top
Subs. SWL	Date	Analysis	Aquifer Test

Driller's Remarks

Top of Lap Pipe or Reduction in Casing FEET

IF TELESCOPED OR MORE THAN ONE SCREEN: USE BACK PAGE

SCREEN DATA

Diameter - Inches	Length - Feet	Slot Size - Inches
2"	10'	.008
Screen Type		**Depth to Bottom - Feet**
PVC		230'

DESCRIPTION OF FORMATIONS ENCOUNTERED	FROM	TO
Top Soil	0	2
Orange Sandy Clay	2	10
Coarse Sand Gravel	10	115
Blue Clay	115	185
Coarse Sand	185	230

FORMATIONS (Continued)	FROM	TO

IF MORE SPACE IS NEEDED, USE BACK

RECEIVED
AUG 28 1996
Dept. of Environmental Quality
Office of Land & Water Resources

If well telescopes please sketch and show depths.

GROUND LEVEL

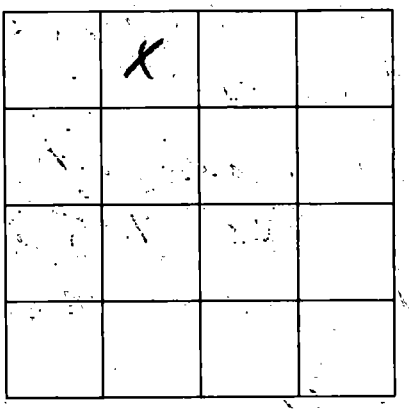

SECTION 23

Please indicate well location X.

ADDITIONAL INFORMATION

RECEIVED

If more than one screen, show location of each on sketch.