Jackson
Q 2063
1-7-80

MISSISSIPPI
BOARD OF WATER COMMISSIONERS
416 North State Street
Jackson, Mississippi 39201

WATER WELL DRILLERS LOG

1/7 1980 Prince Drilling Co. Jackson
date well completed — firm name — county well located

LANDOWNER Arthur Jerkins
Rt 2 Box 4
Pascagoula, Ms 39567
(mailing address)

WELL LOCATION:
sec. 7 T 6 S N R 7 E 4
1 miles N of Pascagoula
(distance) (direction) (nearest town)

WELL PURPOSE:
(home, irrigation, municipal, industrial)

WELL COMPLETION DATA:

(1) diameter (inches) 2"
(2) total depth (feet) 60'
(3) static water level (feet) 26 below/above top of ground.
(4) casing PLASTIC, 50'
(material), (depth)
6
(size) if telescope see back.
(5) screen 10', 50'
(length), (depth to top)
010, PLASTIC
(size), (material)
(6) pump 1 11
(HP) (yield gpm)
Elec
(type power)
(7) electric log (yes or no)
(organization running log)
(8) how well bottom plugged B.W.

DRILLERS REMARKS:

description of formations encountered	from	to
TOP SOIL	0	15
SAND & CLAY	15	25
GOOD SAND	25	60
60		

DEPT. OF NATURAL RESOURCES
BUREAU OF LAND & WATER RESOURCES
FEB 22 1980
RECEIVED

If well telescopes please sketch and show depths.

GROUND LEVEL

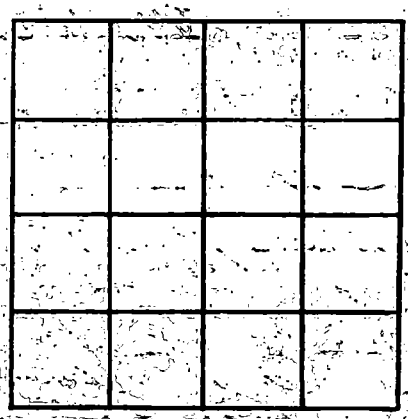

SECTION _____

Please indicate well location X.

ADDITIONAL INFORMATION

If more than one screen, show locations of each on sketch.