JACKSON
Q 2125

MISSISSIPPI DEPARTMENT OF NATURAL RESOURCES

Bureau of Land and Water Resources
Southport Mall
P.O. Box 10631
Jackson, Mississippi 39209

WATER WELL DRILLERS LOG

5-30-84 19 Coast Water Well Serv. Jackson
date well completed — firm name — county well located

LANDOWNER Andrew Tillman
3304 Spruce St.
Pascagoula Miss.
(mailing address)

WELL LOCATION:
sec 22 T 7 N/S R 5 E/W
1/2 miles (distance) E (direction) of Moss Point (nearest town)

WELL PURPOSE: Home
(home, irrigation, municipal, industrial)

WELL COMPLETION DATA:

(1) diameter (inches) 2"
(2) total depth (feet) 225'
(3) static water level (feet) 58' below ~~above~~ top of ground.
(4) casing PVC (material), 215' (depth), ct
2" (size) if telescope see back.
(5) screen 10' (length), 215' (depth to top)
2" (size), PVC (material)
(6) pump 1 hp. (HP) 7 (yield gpm)
Elect. (type power)
(7) electric log No (yes or no)
—
(organization running log)
(8) how well bottom plugged Pack Wash Value

DRILLERS REMARKS:

description of formations encountered	from	to
Top soil	0	5'
Logs & Wood	5'	9'
Red Coarse sand & Wood	9'	39'
Blue Clay	39'	91'
Blue Clay & shell & sand	91'	108'
White Coarse sand & gravel	108'	127'
Blue Clay	127'	178'
Gray Coarse sand	178'	215'
Blue Clay	215'	225' Hole
10 X 2" Tail Pipe.		

DEPT. OF NATURAL RESOURCES
BUREAU OF LAND & WATER RESOURCES
JUL 10 1984
RECEIVED

If well telescopes please sketch and show depths.

GROUND LEVEL

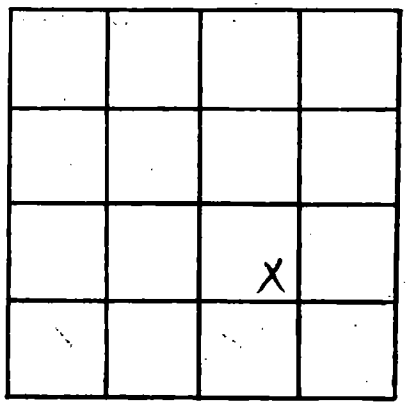

SECTION 22

Please indicate well location X.

ADDITIONAL INFORMATION

If more than one screen, show locations of each on sketch.