MISSISSIPPI DEPARTMENT OF NATURAL RESOURCES

Bureau of Land and Water Resources

P.O. Box 10631
Jackson, Mississippi 39209

WATER WELL DRILLERS LOG

COUNTY WELL LOCATED: Jackson

WELL NUMBER: Q217 | CODED:

PERMIT NUMBER:

DATE WELL COMPLETED: 8-26-89

NAME OF DRILLING FIRM: Coast Water Well Service Inc.

NAME & MAILING ADDRESS OF LANDOWNER:
Sarah Daniels
P.O. Box 5341
Moss Point, Ms.

WELL LOCATION: SEC 27 TOWNSHIP 7 (N) (S) RANGE 5 (E) (W)

DISTANCE: 1/4 Miles DIRECTION: EAST NEAREST TOWN: Moss Point

OTHER LANDMARK:

WELL PURPOSE: Home, Irrigation, Municipal, Industrial, Fish Pond, etc.
Home

PUMP DATA

PUMP TYPE (Circle One): Submersible, Turbine, (Jet), Flowing Well, Other (Describe)

POWER TYPE (Circle One): (Electric), Tractor, Diesel, Gasoline, Butane, Other (Describe) H/P

Pump Capacity (GPM)	No. of Stages	Setting Depth
8 1/2	2	FT.

PUMP TEST

Well yielded _____ GPM with a drawdown of _____ ft. after _____ hours of pumping

WELL DATA

Well Depth	Casing Diameter (In.)	Casing Length (Ft.)
261' 255	2"	245'
Type of Casing	**Hole Depth**	**Depth to Static Water Level**
PVC	261	40'

TYPE OF COMPLETION: (Circle One or More): Gravel Packed, Underreamed, Telescoped, Natural Development, Open Hole, Other (Describe)

Top of Lap Pipe or Reduction in Casing FEET

IF TELESCOPED OR MORE THAN ONE SCREEN: USE BACK PAGE

LOG DATA

TYPE OF LOG RUN (Circle One): No Log Run, Electric, Gamma Ray, Density, Sonic, Neutron, Other (Describe)

Name of Organization Running Log

GEOLOGIC DATA (Office Use Only)

Surface Elev.	Geologic Unit	Unit Thickness	Depth to Top
Subs. SWL	Date	Analysis	Aquifer Test

Driller's Remarks

SCREEN DATA

Diameter - Inches	Length - Feet	Slot Size - Inches
2"	10'	.008
Screen Type	**Depth to Bottom - Feet**	
PVC	255'	

DESCRIPTION OF FORMATIONS ENCOUNTERED	FROM	TO
Top soil	0	5
Coarse sand	5	15
Blue Clay	15	55
Coarse sand/gravel	55	85
Blue Clay	85	90
Coarse sand	90	120
Blue Clay	120	145
Fine sand	145	225
Coarse sand	225	261

FORMATIONS (Continued)

FROM	TO

RECEIVED
NOV 21 1989
Department of Natural Resources
Bureau of Land & Water Resources

IF MORE SPACE IS NEEDED, USE BACK

If well telescopes please sketch and show depths.

GROUND LEVEL

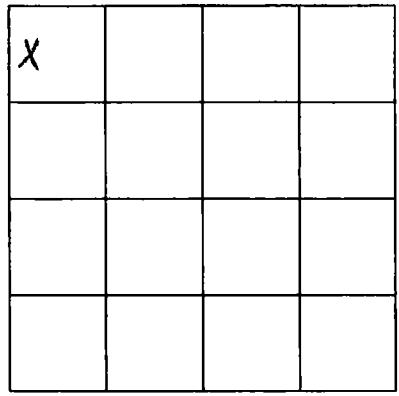

SECTION 27

Please indicate well location X.

ADDITIONAL INFORMATION

If more than one screen, show location of each on sketch.