MISSISSIPPI DEPARTMENT OF ENVIRONMENTAL QUALITY
Office of Land and Water Resources

P. O. Box 10631
Jackson, MS 39289-0631
WATER WELL DRILLERS LOG

COUNTY WELL LOCATED	Jackson
WELL NUMBER	2205
CODED	
DATE WELL COMPLETED	10-26-93
PERMIT NUMBER	
NAME OF DRILLING FIRM	Coast Water Well Ser Inc

NAME & MAILING ADDRESS OF LANDOWNER
Earl Johnson
Gregory St.
Moss Point, Ms. 39563

WELL LOCATION: SEC 30 TOWNSHIP 7 (N) (S) RANGE 5 (E) (W)

DISTANCE 1N Miles — DIRECTION — of NEAREST TOWN Moss Point

OTHER LANDMARK

WELL PURPOSE: Home, (Irrigation), Municipal, Industrial, Fish Pond, etc.
LAWN CARE

PUMP DATA

PUMP TYPE (Circle One): Submersible, Turbine, (Jet), Flowing Well, Other (Describe) ____

POWER TYPE (Circle One): (Electric), Tractor, Diesel, Gasoline, Butane, Other (Describe) ____ H/P 1/2

Pump Capacity (GPM)	No. of Stages	Setting Depth
8	1	FT.

PUMP TEST

Well yielded ____ GPM with a drawdown of ____ ft. after ____ hours of pumping

WELL DATA

Well Depth	Casing Diameter (In.)	Casing Length (Ft.)
85'	2"	75'

Type of Casing	Hole Depth	Depth to Static Water Level
PVC	85'	25'

TYPE OF COMPLETION: (Circle One or More): Gravel Packed, Underreamed, Telescoped, (Natural Development), Open Hole, Other (Describe) ____

WELL GROUTED TO A DEPTH OF 20 FEET
Type Grout (circle one): Cement, (Bentonite), or Mix

LOG DATA

TYPE OF LOG RUN (Circle One): (No Log Run), Electric, Gamma Ray, Density, Sonic, Neutron, Other (Describe) ____

Name of Organization Running Log

GEOLOGIC DATA (Office Use Only)

Surface Elev.	Geologic Unit	Unit Thickness	Depth to Top
Subs. SWL	Date	Analysis	Aquifer Test

Driller's Remarks

SCREEN DATA

Diameter - Inches	Length - Feet	Slot Size - Inches
2"	10'	.008

Screen Type	Depth to Bottom - Feet
PVC	85'

DESCRIPTION OF FORMATIONS ENCOUNTERED	FROM	TO
top soil	0	2
Red Clay	2	20
Blue Clay/shell	20	60
Coarse sand-pea gravel	60	85

FORMATIONS (continued)	FROM	TO

RECEIVED
DEC 14 1993
Dept. of Environmental Quality
Office of Land & Water Resources

IF MORE SPACE IS NEEDED, USE BACK

If well telescopes please
sketch and show depths.

GROUND LEVEL

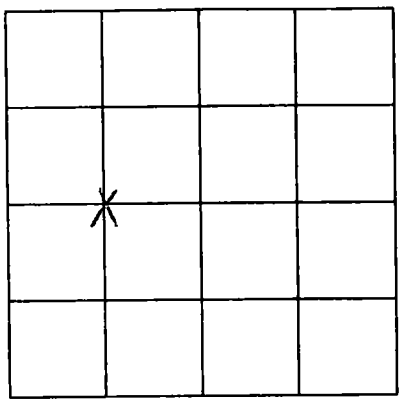

SECTION 30

Please indicate well location X.

ADDITIONAL INFORMATION

If more than one screen,
show location of each on sketch.