MISSISSIPPI DEPARTMENT OF ENVIRONMENTAL QUALITY
Office of Land and Water Resources

P. O. Box 10631
Jackson, MS 39289-0631
WATER WELL DRILLERS LOG

COUNTY WELL LOCATED: Jackson	
WELL NUMBER: Q	CODED: 2247
DATE WELL COMPLETED: 12-29-99	
PERMIT NUMBER:	
NAME OF DRILLING FIRM: Coast Water Well Service	

NAME & MAILING ADDRESS OF LANDOWNER
William Blackman
Japonica Way
Pascagoula, Ms

WELL LOCATION	SEC	TOWNSHIP	RANGE
	3	7 N (S)	5 E (W)

DISTANCE	DIRECTION	NEAREST TOWN
2 1/2 Miles	5	of Helena

OTHER LANDMARK:

WELL PURPOSE: Home, Irrigation, Municipal, Industrial, Fish Pond, etc.
Horses

PUMP DATA

PUMP TYPE (Circle One): Submersible, Turbine, (Jet) Flowing Well, Other (Describe) _____

POWER TYPE (Circle One): (Electric) Tractor, Diesel, Gasoline, Butane, Other (Describe) _____ H/P 1

Pump Capacity (GPM)	No. of Stages	Setting Depth
8	2	FT.

PUMP TEST

Well yielded _____ GPM with a drawdown of _____ ft. after _____ hours of pumping

WELL DATA

Well Depth	Casing Diameter (In.)	Casing Length (Ft.)
185'	2"	175'

Type of Casing	Hole Depth	Depth to Static Water Level
PVC	185'	8'

TYPE OF COMPLETION: (Circle One or More): Gravel Packed, Underreamed, Telescoped, (Natural Development) Open Hole, Other (Describe) _____

WELL GROUTED TO A DEPTH OF 20 FEET
Type Grout (circle one): Cement, (Bentonite) or Mix

LOG DATA

TYPE OF LOG RUN (Circle One): (No Log Run), Electric, Gamma Ray, Density, Sonic, Neutron, Other (Describe) _____

Name of Organization Running Log

GEOLOGIC DATA (Office Use Only)

Surface Elev.	Geologic Unit	Unit Thickness	Depth to Top
Subs. SWL	Date	Analysis	Aquifer Test

Driller's Remarks

Top of Lap Pipe or Reduction in Casing
FEET

IF TELESCOPED OR MORE THAN ONE SCREEN: USE BACK PAGE

SCREEN DATA

Diameter - Inches	Length - Feet	Slot Size - Inches
2"	10'	.008

Screen Type	Depth to Bottom - Feet
PVC	185'

DESCRIPTION OF FORMATIONS ENCOUNTERED	FROM	TO	FORMATIONS (Continued)	FROM	TO
Top Soil	0	2			
Orange Clay	2	10			
Coarse Sand & Gravel	10	105			
Blue Clay	105	155			
Med Coarse Sand	155	185			
			IF MORE SPACE IS NEEDED, USE BACK		

If well telescopes please sketch and show depths.

GROUND LEVEL

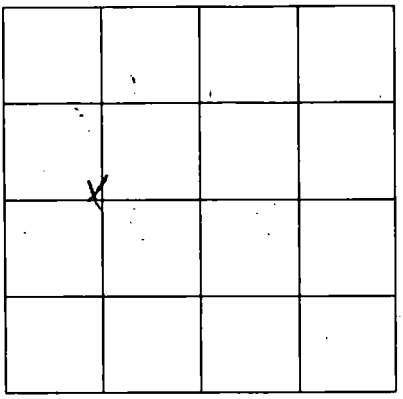

SECTION 3

Please indicate well location X.

ADDITIONAL INFORMATION

If more than one screen, show location of each on sketch.