Harrison 5-9 #1

County: Jasper

Permit #:

Driller: John W Thompson

Date drilling completed: 9-24-12

State Well Report

Part 1

Mississippi Department of Environmental Quality
Office of Land and Water Resources
P.O. Box 10631
Jackson, MS 39289-0631
(601)961-5210
(601)354-6938 (fax)

For Office Use Only:

Aquifer:

Well #: P66

L. S. Elevation:

E-log #:

State Law requires that this report be prepared by the driller in detail and filed with the Department within 30 days of completion of drilling of the well.

Well Owner Information

Owner Name: Rennaissance

Mailing Address: 17625 El Camino ste 200
Houston TX 77058

City State Zip Code

Telephone No. ( )

Well Location

Latitude: 31 · 57 · 08 " Longitude: 089 · 05 · 50 "

Method of Lat/Long (circle one): Conventional Survey, USGS quad, Hand-held GPS, Survey-grade GPS

NW ¼ SW ¼ Sec 5 Twn 1N Rng 11W

Distance 6 Miles Direction NW of Nearest Town Heidelberg

Well Data

Purpose of Well (circle one) Home Industrial Public Supply Irrigation Fish Culture Other: rig supply

Date well drilling started: 9-22-12 Date well drilling completed: 9-24-12

If flowing, method of flow regulation: Valve _____ Other (describe) _____

Static Water Level: _____ feet above or below (circle one) land surface Date measured: _____

Method of Measurement (circle one) steel tape electric tape air line other: _____

Hole depth: 563 Well depth: 540 Well grouted to a depth of 20 feet

Type of grout (circle one): Cement Bentonite Mix

Casing length: 440 feet Casing diameter: 4 inches Type of casing: PVC

Screen length: 100 feet Screen diameter: 4 inches Type of screen: PVC Slotted

Screen slot size: .008 inches Setting depth: From 440 feet to 540 feet

Type of completion (circle all applicable): Gravel packed Underreamed Telescoped Open hole ~~Natural Development~~

Other (describe): _____

Top of lap pipe or reduction in casing: _____ feet. If telescoped or more than one screen, describe on back of page

Logs run (circle all applicable): No log run Electric Gamma Ray Density Sonic Neutron Other: _____

Name of organization running log(s):

I certify that the well was drilled, constructed, and completed in accordance with all applicable requirements of the Mississippi Department of Environmental Quality and/or the Mississippi Department of Health regulations and state laws.

John W Thompson 0-679
Print Name of Water Well Contractor and License No.

John W Thompson
Signature of Water Well Contractor

RECEIVED
OCT 02 2012
BY: OLWR

P66

If well telescopes please sketch below and show depths.

Ground Level

Description of Formations Encountered	From	To
Clay	0	440
Sand	440	520
sand & clay	520	540
Clay	540	563

If more than one screen, show location of each on sketch

Sketch the property layout and include the following: 1) the well location; 2) any permanent structures on the property that may aid in locating the well; 3) any roads, power lines, or other items that may aid in locating the property and the well; 4) indicate direction.

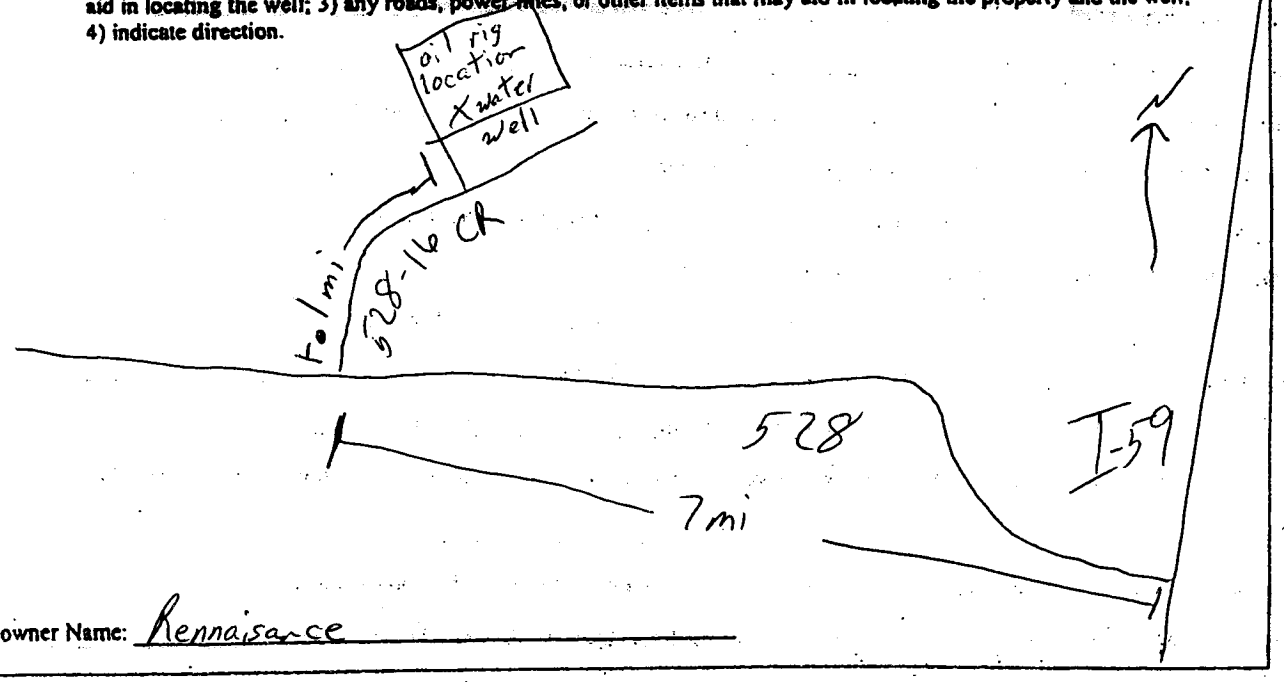

Landowner Name: Rennaisance

John W Thompson

Signature of Water Well Contractor

MISSISSIPPI DEPARTMENT OF ENVIRONMENTAL QUALITY
Office of Land and Water Resources

P.O. Box 10631
Jackson, MS 39289
Water Well Plugging
Decommissioning

COUNTY WELL LOCATED	Jasper
WELL NUMBER	P66
CODED	
DATE WELL PLUGGED	10-2-12
PERMIT NUMBER	
NAME OF DRILLING FIRM	Thompson Brothers
NAME & MAILING ADDRESS OF LANDOWNER	Renaissance 17625 El Camino ste 200 Houston TX 77058
WELL LOCATION SEC	5
TOWNSHIP	1N
RANGE	11W
DISTANCE	6 mi
DIRECTION	NW
NEAREST TOWN	Heidelberg
OTHER LANDMARK	
WELL PURPOSE: HOME, IRRIGATION, MUNICIPAL, INDUSTRIAL, FISH POND, ECT.	rig supply
NAME OF WELL CONTRACTOR WHO DRILLED THE WELL	Thompson Bros.
NAME OF LANDOWNER WHEN WELL WAS DRILLED	Renaissance
WELL DATA	
Well Depth	540
Casing Diameter (In.)	4
Casing Length (Ft.)	440
Type of Casing	PVC
Hole Depth	563
Depth to Static Water Level	
DATE WELL COMPLETED	9-24-12

DESCRIBE HOW THE WELL OF HOLE WAT PLUGGED:
(AMOUNT OF CASING AND/OR SCREEN THAT WAS REMOVED, OR LEFT IN HOLE, MATERIAL USED IN PLUGGING, ETC.)

Ran drill pipe to bottom of well. Pumped bentonit "Grantwell PF" slurry to surface. Cut casing below ground.

I CERTIFY THAT THE WELL WAS PLUGGED OR ABANDONED IN ACCORDANCE WITH THE STATE OF MISSISSIPPI REFULATIONS.

John W Thompson 0-679 — SIGNATURE

10-3-12 — DATE

RECEIVED
OCT 2012
BY: OLWR