Jefferson DAVIS
E 2009
1981

MISSISSIPPI
BOARD OF WATER COMMISSIONERS
416 North State Street
Jackson, Mississippi 39201

WATER WELL DRILLERS LOG

19 Tom Griffith Well Serv Jefferson Davis
date well completed — firm name — county well located

LANDOWNER: Willie Hall
Prentiss
(mailing address)

WELL LOCATION:
sec. 27 T 8 N R 19 W
4 miles S.W. of Prentiss
(distance) (direction) (nearest town)

WELL PURPOSE:
(home, irrigation, municipal, industrial)

WELL COMPLETION DATA:

(1) diameter (inches) 2"
(2) total depth (feet) 240
(3) static water level (feet) 190 below ~~above~~ top of ground
(4) casing Plastic (material), 24" (depth),
n/a (size) if telescope see back.
(5) screen 20 Feet (length), 240 to 220 (depth to top)
2" (size), Plastic (material)
(6) pump 2 (HP) 15 (yield gpm)
S/P (type power)
(7) electric log no (yes or no)
n/a (organization running log)
(8) how well bottom plugged D.W.V.

DRILLERS REMARKS:

description of formations encountered	from	to
Top Soil	0	4
Clay	4	20
Sand	20	240

DEPT. OF NATURAL RESOURCES
BUREAU OF LAND & WATER RESOURCES
OCT 20 1981
RECEIVED

If well telescopes please sketch and show depths.

GROUND LEVEL

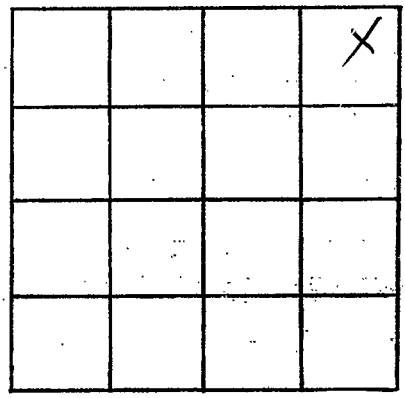

SECTION 27

Please indicate well location X.

ADDITIONAL INFORMATION

If more than one screen, show locations of each on sketch.