

283

STATE WELL REPORT

Part 1

Driller's Log

Mississippi Department of Environmental Quality
 Office of Land and Water Resources
 P.O. Box 2309
 Jackson, MS 39225-2309
 (601)961-5210
 (601)360-0535 (fax)

County: Jones
 Permit #: _____
 Driller: A-1 Drilling Serv. Inc
 Date drilling completed: 5-15-19

For Office Use Only:
 Well #: F125
 Aquifer: _____
 E-Log #: _____

State Law requires that this report be prepared by the license holder responsible for the work and filed with the Department at the above address within 30 days of completion of drilling of the well or borehole.

Well Owner Information (Landowner if borehole is not for a water well)	Well or Borehole Location
Owner Name: <u>Scott Kiewitt</u>	Latitude: <u>31° 38' 44" N</u> Longitude: <u>89° 12' 45" W</u>
Mailing Address: <u>33 Kimberly Dr.</u>	Method of Lat/Long (check one): Conventional Survey _____ USGS quad _____, Hand-held GPS <input checked="" type="checkbox"/> , Survey-grade GPS _____
<u>Laurel</u> <u>Ms.</u> <u>39440</u>	<u>NW</u> ¼ <u>SW</u> ¼, Sec. <u>21</u> T. <u>8N</u> R. <u>12W</u>
City State Zip Code	<u>1</u> Miles <u>SW</u> of <u>Laurel</u>
Telephone No. <u>(601) 319-2856</u>	(Distance) (Direction) (Nearest Town)

Well / Borehole Data

Date drilling started: 5-7-19 Date drilling completed: 5-15-19 Hole depth: 315' Hole diameter: 6 3/4"

Location of the source of any surface water used for drilling: Pleasant Ridge W.A.

Method of dosing and volume of Chlorine used in drilling and development: _____

Logs run (circle all applicable): No log run Electric Gamma Ray Density Sonic Neutron Other: _____

Name of organization running log(s): _____

Purpose of borehole (circle one): Water Well Geotechnical/Geological Investigation Ground Source Heat Pump
 Seismic Survey Other (describe) _____

If drilling is not related to water well construction, skip the remainder of this block

Purpose of Well (circle all applicable): Home Industrial Public Supply Irrigation Fish Culture

Other (describe): _____

If a flowing well, method of flow regulation: Valve _____ Other (describe) _____

Static Water Level: 101 feet [above or below] land surface Date measured: _____
(circle one)

Method of measurement (circle one): Steel tape Electric tape Air line Other (describe): Sonic

Well depth: 315 Well grouted to a depth of: 20 feet Type of grout (circle one): Neat Cement Bentonite Mix

Casing length: 295 feet Casing diameter: 4 inches Type of casing: PVC

Screen length: 20 feet Screen diameter: 4 inches Type of screen: slotted PVC

Screen slot size: .006 inches Setting depth: From 295 feet to 315 feet

Type of completion (circle all applicable): Gravel packed Underreamed Open hole Natural Development

Other (describe): _____

Top of lap pipe or reduction in casing: _____ feet

If telescoped or more than one screen, describe on next page


RECEIVED
 MAY 30 2019
 BY OLWR

RECEIVED
MAY 30 2019
BY OLWR

County: _____
 Permit #: _____

For Office Use Only:
 Well #: F125


The sketch below only required for water wells
If well telescopes, show depths on sketch.

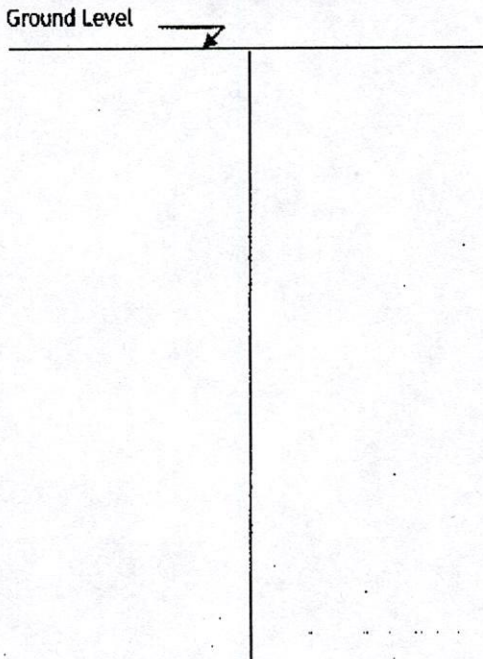

Description of formations encountered must be provided for all wells and boreholes, unless specifically exempted by regulations

Description of Formations Encountered	From (depth) Ground level	To (depth)
Orange Sandy clay	Ground level	10
Tan sand	10	17
White clay	17	41
Sand stone	41	41
Light gray clay	41	83
Sandy clay gray	83	117
Sand	117	123
Tan clay	123	134
Sandy light gray clay	134	224
Gray clay	224	298
Sand	298	315
Clay	315	317

If more than one screen, show location of each on sketch

 

Landowner Name: Scott Kiewitt

I HEREBY CERTIFY that the well/borehole was drilled, constructed, and completed in accordance with all applicable requirements of the Mississippi Department of Environmental Quality and the Mississippi Department of Health regulations, if applicable, and state laws.

Mike Baughman 587 5-20-19 Mike Baughman
 Print Name of Responsible Licensee and License No. Date Signature of Licensee

Form: OLWR-SWR-1A (4/13)

STATE WELL REPORT

Part 2

County: Jones
 Permit #: _____
 Driller: A-1 Drilling Serv. Inc.
 Date completed: _____
Copy information from block on Part 1

Pump Installer's Completion Report
 Mississippi Department of Environmental Quality
 Office of Land and Water Resources
 P.O. Box 2309
 Jackson, MS 39225-2309
 (601)961-5210
 (601) 360-0535 (fax)

For Office Use Only:
 Well #: F125
 Aquifer: _____

This part of the report must be completed by a licensed water well contractor, or a licensed pump installer. A copy of Part 1 of the report must be attached and both parts filed with the Department at the above address within 30 days of well completion.

Well Owner Information			Well Location	
Owner Name: <u>Scott Kiewitt</u>			Latitude: <u>31° 38' 44" N</u> Longitude: <u>89° 12' 45" N</u>	
Mailing Address: <u>33 Kimberly Dr.</u>			Method of Lat/Long (check one): Conventional Survey _____	
City: <u>Laurel</u> State: <u>Ms.</u> Zip Code: <u>39440</u>			USGS quad _____, Hand-held GPS <input checked="" type="checkbox"/> , Survey-grade GPS _____	
Telephone No. (601) <u>319-2856</u>			<u>NW</u> ¼ <u>SW</u> ¼, Sec. <u>21</u> T <u>8N</u> R <u>12W</u>	
			<u>1</u> Miles <u>SW</u> of <u>Laurel</u>	
			(Distance) (Direction) (Nearest Town)	

Pump Type (circle one)
 Submersible Turbine Air Lift Centrifugal Flowing Well Jet Piston Rotary Other (describe): _____

Date Pump Installed: 5-21-19 Rated Pump Capacity: 45 Gallons Per Minute

Is This Pump (circle one): New Repaired Replacement

Power Type (circle one)
 Electric Diesel Gasoline Natural Gas Tractor PTO Windmill Other (describe): _____

Horse Power Rating of Motor: 5 Setting Depth: 160 feet Number of Stages: 17

RECEIVED
MAY 30 2019
BY OLWR

Pump Test Data for Non Flowing Well

Date Well Tested: _____ Duration of Pump Test (minimum 4 hours): _____ hours

Static Water Level (A): 101' Feet Below Land Surface Pumping Water Level (B): _____ Feet Below Land Surface

Drawdown [(B) - (A)]: _____ Feet Below Land Surface Test Pumping Rate: _____ Gallons Per Minute

Method of measurement (circle one): Steel tape Electric tape Air line Other (describe): SONIC

Pump Test Data for Flowing Well

Measured shut in head: _____ feet.

Well yielded _____ GPM with a drawdown of _____ feet after _____ hours of pumping

Meter Installation

Meter Manufacturer: _____ Meter Serial Number: _____

Meter Model Number/Name: _____ Type of Meter: _____

Totalizer Register Unit and Multiplier Factor (AF x .001, gal x 1000, etc): _____

Installation Date: _____ Meter Installed by: _____

Is This Meter (circle one): New Repaired Replacement

Important: By submitting the above information you are certifying that this meter was installed to manufacturer standards. For agricultural wells, a list of approved meters is on the MDEQ website.

I HEREBY CERTIFY that the above statements are true to the best of my knowledge.

Mike Baughman 587 5-20-19 [Signature]
 Print Name of Pump Installer and License No. (if applicable) Date Signature of Pump Installer