MISSISSIPPI DEPARTMENT OF ENVIRONMENTAL QUALITY
Office of Land and Water Resources

P. O. Box 10631
Jackson, MS 39289-0631

WATER WELL DRILLERS LOG

COUNTY WELL LOCATED	Lawrence
WELL NUMBER	F 2010
CODED	
PERMIT NUMBER	
NAME OF DRILLING CO.	Grenn Water Well & Supply 1318 Pricedale Dr. SE Bogue Chitto, MS 39629
DATE WELL COMPLETED	3-20-96

NAME & MAILING ADDRESS OF LANDOWNER
Randy Carr
Rt 1 Box 170C
Monticello MS

WELL LOCATION: SEC 14 TOWNSHIP 7 (N) S RANGE 10 (E) W

DISTANCE 3 Miles **DIRECTION** W of **NEAREST TOWN** Monticello

OTHER LANDMARK

WELL PURPOSE: Home, Irrigation, Municipal, Industrial, Fish Pond, etc.
home

PUMP DATA

PUMP TYPE (Circle One): Submersible, Turbine, Jet, Flowing Well, Other (Describe) ____

POWER TYPE (Circle One): Electric, Tractor, Diesel, Gasoline, Butane, Other (Describe) 3/4 H/P ____

Pump Capacity (GPM)	No. of Stages	Setting Depth
10		57 FT.

PUMP TEST

Well yielded 10 GPM with a drawdown of 20 ft. after 5 min. hours of pumping

WELL DATA

Well Depth	Casing Diameter (In.)	Casing Length (Ft.)
60'	4"	50

Type of Casing	Hole Depth	Depth to Static Water Level
PVC	70	34

TYPE OF COMPLETION: (Circle One or More): Gravel Packed, Underreamed, Telescoped, Natural Development, Open Hole, Other (Describe) ____

WELL GROUTED TO A DEPTH OF 10 FEET
Type Grout (circle one): Cement, Bentonite, or Mix

LOG DATA

TYPE OF LOG RUN (Circle One): No Log Run, Electric, Gamma Ray, Density, Sonic, Neutron, Other (Describe) ____

Name of Organization Running Log

GEOLOGIC DATA (Office Use Only)

Surface Elev.	Geologic Unit	Unit Thickness	Depth to Top
Subs. SWL	Date	Analysis	Aquifer Test

Driller's Remarks

SCREEN DATA

Diameter - Inches	Length - Feet	Slot Size - Inches
4	10	.010

Screen Type	Depth to Bottom - Feet
PVC	40

Top of Lap Pipe or Reduction in Casing
FEET
IF TELESCOPED OR MORE THAN ONE SCREEN, USE BACK PAGE

DESCRIPTION OF FORMATIONS ENCOUNTERED	FROM	TO
Red Clay	0	16
Clay / Gravel Mix	16	38
Sand & Gravel	38	42
White Clay	42	70

FORMATIONS (continued)	FROM	TO

IF MORE SPACE IS NEEDED, USE BACK

RECEIVED
JUN 21 1996
Dept. of Environmental Quality
Office of Land & Water Resources

If well telescopes please sketch and show depths.

GROUND LEVEL

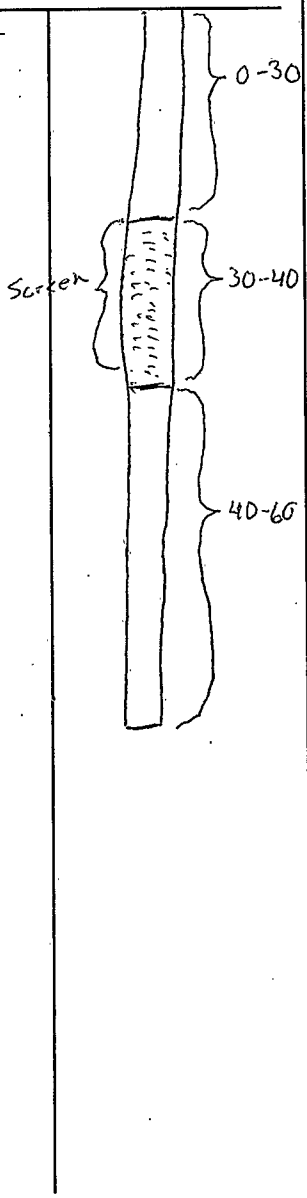

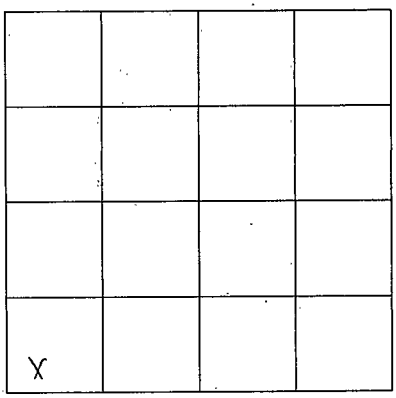

SECTION 14

Please indicate well location X.

ADDITIONAL INFORMATION

If more than one screen, show location of each on sketch.