MISSISSIPPI DEPARTMENT OF ENVIRONMENTAL QUALITY
Office of Land and Water Resources

P. O. Box 10631
Jackson, MS 39289-0631
WATER WELL DRILLERS LOG

COUNTY WELL LOCATED	LAWRENCE
WELL NUMBER	F 2014
CODED	
DATE WELL COMPLETED	5-18-98
PERMIT NUMBER	0-287
NAME OF DRILLING FIRM	Reeves Well Ser.

NAME & MAILING ADDRESS OF LANDOWNER
Joe Daniels
HWY 84 E

WELL LOCATION: SEC 30 TOWNSHIP 7 (N) S RANGE 10 (E) W

DISTANCE 8 Miles DIRECTION W of NEAREST TOWN Monticello

OTHER LANDMARK

WELL PURPOSE: Home, Irrigation, Municipal, Industrial, Fish Pond, etc.
Home

PUMP DATA

PUMP TYPE (Circle One): (Submersible) Turbine, Jet Flowing Well, Other (Describe) _____

POWER TYPE (Circle One): (Electric) Tractor, Diesel, Gasoline, Butane, Other (Describe) _____ H/P 1/2

Pump Capacity (GPM)	No. of Stages	Setting Depth
10	8	90 FT.

PUMP TEST

Well yielded 50 GPM with a drawdown of 0 ft. after 1 hours of pumping

WELL DATA

Well Depth	Casing Diameter (In.)	Casing Length (Ft.)
115	4"	20'
Type of Casing	**Hole Depth**	**Depth to Static Water Level**
PVC	115	60'

TYPE OF COMPLETION: (Circle One or More): Gravel Packed, Underreamed, Telescoped, Natural Development, Open Hole, Other (Describe) 10 gal bond

WELL GROUTED TO A DEPTH OF 10 FEET
Type Grout (circle one): (Cement) Bentonite, or Mix

LOG DATA

TYPE OF LOG RUN (Circle One): No Log Run, Electric, Gamma Ray, Density, Sonic, Neutron, Other (Describe) _____

Name of Organization Running Log

GEOLOGIC DATA (Office Use Only)

Surface Elev.	Geologic Unit	Unit Thickness	Depth to Top
Subs. SWL	Date	Analysis	Aquifer Test

Driller's Remarks

Top of Lap Pipe or Reduction in Casing
FEET — IF TELESCOPED OR MORE THAN ONE SCREEN: USE BACK PAGE

SCREEN DATA

Diameter - Inches	Length - Feet	Slot Size - Inches
4"	10'	10 Thds.
Screen Type		**Depth to Bottom - Feet**
PVC		115'

DESCRIPTION OF FORMATIONS ENCOUNTERED	FROM	TO	FORMATIONS (Continued)	FROM	TO
Clay	0	10			
sand & gravel	10	60			
Chalk	60	95			
sand & pea gravel	95	115			
			IF MORE SPACE IS NEEDED, USE BACK		

06-23-98 09:30 RCVD

If well telescopes please
sketch and show depths.

GROUND LEVEL

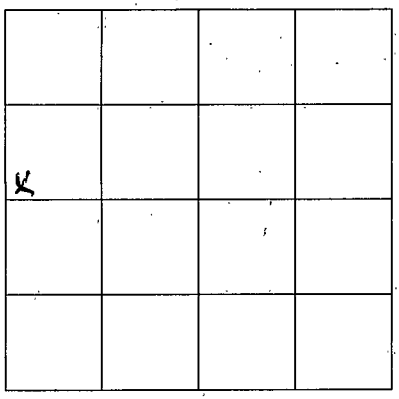

SECTION 30

Please indicate well location X.

ADDITIONAL INFORMATION

If more than one screen,
show location of each on sketch.