MISSISSIPPI DEPARTMENT OF ENVIRONMENTAL QUALITY
Office of Land and Water Resources

P. O. Box 10631
Jackson, MS 39289-0631
WATER WELL DRILLERS LOG

COUNTY WELL LOCATED	Lawrence
WELL NUMBER	F 2021
CODED	
PERMIT NUMBER	
NAME OF DRILLING FIRM	Thompson Brothers
DATE WELL COMPLETED	3-21-00

NAME & MAILING ADDRESS OF LANDOWNER
Key Production
1340 Poydras St. Suite 1700
New Orleans LA. 70112

WELL LOCATION	SEC	TOWNSHIP	RANGE
	36	7 (N) S	10 (E) W

DISTANCE	DIRECTION	NEAREST TOWN
1 Miles	W of	Monticello

OTHER LANDMARK

WELL PURPOSE: Home, Irrigation, Municipal, Industrial, Fish Pond, etc.
Rig Supply

PUMP DATA

PUMP TYPE (Circle One): (Submersible), Turbine, Jet, Flowing Well, Other (Describe)

POWER TYPE (Circle One): (Electric), Tractor, Diesel, Gasoline, Butane, Other (Describe) H/P 5

Pump Capacity (GPM)	No. of Stages	Setting Depth
55		200 FT.

PUMP TEST
Well yielded 40 GPM with a drawdown of 50 ft. after air lift ~~hours of pumping~~

WELL DATA

Well Depth	Casing Diameter (In.)	Casing Length (Ft.)
250	4	210

Type of Casing	Hole Depth	Depth to Static Water Level
PVC	268	62'

TYPE OF COMPLETION: (Circle One or More): (Gravel Packed), Underreamed, Telescoped, Natural Development, Open Hole, Other (Describe)

WELL GROUTED TO A DEPTH OF 10 FEET
Type Grout (circle one): Cement, Bentonite, or Mix

LOG DATA

TYPE OF LOG RUN (Circle One): (No Log Run), Electric, Gamma Ray, Density, Sonic, ~~Neutron~~, Other (Describe)

Name of Organization Running Log

GEOLOGIC DATA (Office Use Only)

Surface Elev.	Geologic Unit	Unit Thickness	Depth to Top
Subs. SWL	Date	Analysis	Aquifer Test

Driller's Remarks

SCREEN DATA

Diameter - Inches	Length - Feet	Slot Size - Inches
4	40	.010

Screen Type	Depth to Bottom - Feet
PVC Slot	250

DESCRIPTION OF FORMATIONS ENCOUNTERED	FROM	TO	FORMATIONS (Continued)	FROM	TO
Clay	0	21			
Rock	21	25			
Clay & Rock streaks	25	50			
clay	50	209			
fine sand	209	214			
med. sand	214	226			
clay	226	250			
			IF MORE SPACE IS NEEDED, USE BACK		

If well telescopes please
sketch and show depths.

GROUND LEVEL

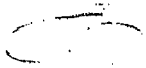

If more than one screen,
show location of each on sketch.

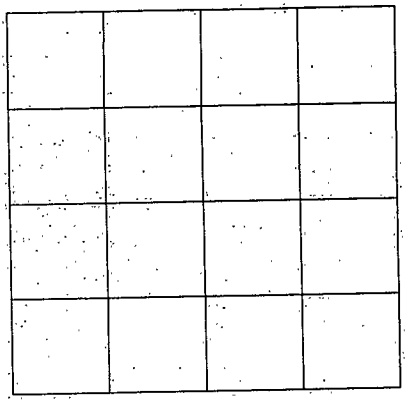

SECTION _____

Please indicate well location X.

ADDITIONAL INFORMATION