6/17

MISSISSIPPI DEPARTMENT OF ENVIRONMENTAL QUALITY

Office of Land and Water Resources

P. O. Box 10631
Jackson, MS 39289-0631

WATER WELL DRILLERS LOG

COUNTY WELL LOCATED: Lawrence

WELL NUMBER: F-2022 | CODED:

DATE WELL COMPLETED: 6-18-99

NAME OF DRILLING FIRM: Glenn Water Well & Supply, 1318 Pricedale Dr. SE, Bogue Chitto, MS 39629

NAME & MAILING ADDRESS OF LANDOWNER: Phillip Russell, Rt. 1, Box 213A, Monticello

WELL LOCATION: SEC 31 TOWNSHIP 7 (N) S RANGE 10 (E) W

DISTANCE: 6 Miles DIRECTION: W of NEAREST TOWN: Monticello

OTHER LANDMARK:

WELL PURPOSE: (Home), Irrigation, Municipal, Industrial, Fish Pond, etc.

PUMP DATA

PUMP TYPE (Circle One): (Submersible), Turbine, Jet, Flowing Well, Other (Describe)

POWER TYPE (Circle One): (Electric), Tractor, Diesel, Gasoline, Butane, Other (Describe) H/P 3/4

Pump Capacity (GPM)	No. of Stages	Setting Depth
10	12	140 FT.

PUMP TEST

Well yielded 10 GPM with a drawdown of 5 ft. after 1 hours of pumping

WELL DATA

Well Depth	Casing Diameter (In.)	Casing Length (Ft.)
160'	4"	150'

Type of Casing	Hole Depth	Depth to Static Water Level
PVC	175'	98'

TYPE OF COMPLETION: (Circle One or More): (Gravel Packed), Underreamed, Telescoped, Natural Development, Open Hole, Other (Describe)

WELL GROUTED TO A DEPTH OF 10 FEET
Type Grout (circle one): Cement, Bentonite, or (Mix)

LOG DATA

TYPE OF LOG RUN (Circle One): (No Log Run), Electric, Gamma Ray, Density, Sonic, Neutron, Other (Describe)

Name of Organization Running Log

GEOLOGIC DATA (Office Use Only)

Surface Elev.	Geologic Unit	Unit Thickness	Depth to Top
Subs. SWL	Date	Analysis	Aquifer Test

Driller's Remarks

SCREEN DATA

Diameter - Inches	Length - Feet	Slot Size - Inches
4"	10'	.010

Screen Type	Depth to Bottom - Feet
PVC	160'

Top of Lap Pipe or Reduction in Casing FEET

IF TELESCOPED OR MORE THAN ONE SCREEN: USE BACK PAGE

RECEIVED JUN 01 2000 Dept. of Environmental Quality Office of Land & Water Resources

DESCRIPTION OF FORMATIONS ENCOUNTERED	FROM	TO	FORMATIONS (Continued)	FROM	TO
Red Clay	0	30			
Gravel	30	56			
White Clay	56	116			
Sand/Gravel	116	175			
			IF MORE SPACE IS NEEDED, USE BACK		

If well telescopes please
sketch and show depths.

GROUND LEVEL

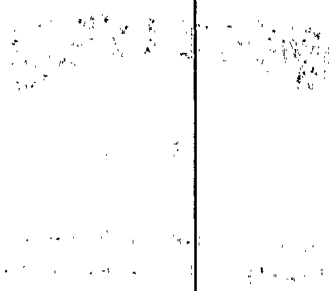

If more than one screen,
show location of each on sketch.

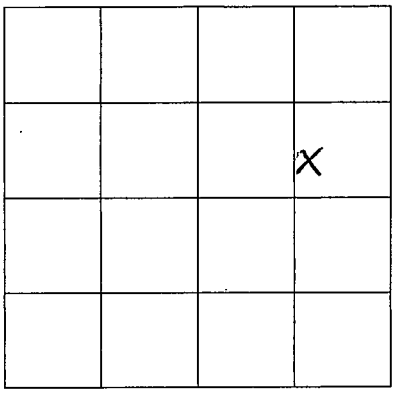

SECTION 31

Please indicate well location X.

ADDITIONAL INFORMATION