MISSISSIPPI DEPARTMENT OF NATURAL RESOURCES

Bureau of Land and Water Resources

P.O. Box 10631
Jackson, Mississippi 39209

WATER WELL DRILLERS LOG

COUNTY WELL LOCATED: Lawrence	
WELL NUMBER: 329845	CODED:
F-2023	
DATE WELL COMPLETED: 10-13-99	

PERMIT NUMBER: 510	
NAME OF DRILLING FIRM: Easley Waterwell	
Brookhaven MS	

NAME & MAILING ADDRESS OF LANDOWNER: WRQR

WELL LOCATION: SEC 5 TOWNSHIP 7 (N) S RANGE 10 (E) W

DISTANCE _____ Miles DIRECTION _____ of NEAREST TOWN _____

OTHER LANDMARK

WELL PURPOSE: Home, Irrigation, Municipal, Industrial, Fish Pond, etc.

PUMP DATA

PUMP TYPE (Circle One): Submersible, Turbine, Jet Flowing Well, Other (Describe) _____

POWER TYPE (Circle One): Electric, Tractor, Diesel, Gasoline, Butane, Other (Describe) _____

Pump Capacity (GPM)	No. of Stages	Setting Depth
		FT.

PUMP TEST

Well yielded _____ GPM with a drawdown of _____ ft. after _____ hours of pumping

WELL DATA

Well Depth	Casing Diameter (In.)	Casing Length (Ft.)
125'	4"	105'

Type of Casing	Hole Depth	Depth to Static Water Level
PVC	140'	

TYPE OF COMPLETION: (Circle One or More): Gravel Packed, Underreamed, Telescoped, Natural Development, Open Hole, Other (Describe) _____

Top of Lap Pipe or Reduction in Casing FEET

IF TELESCOPED OR MORE THAN ONE SCREEN: USE BACK PAGE

LOG DATA

TYPE OF LOG RUN (Circle One): No Log Run, Electric, Gamma Ray, Density, Sonic, Neutron, Other (Describe) _____

Name of Organization Running Log

GEOLOGIC DATA (Office Use Only)

Surface Elev.	Geologic Unit	Unit Thickness	Depth to Top
Subs. SWL	Date	Analysis	Aquifer Test

Driller's Remarks

SCREEN DATA

Diameter - Inches	Length - Feet	Slot Size - Inches
4"	20'	0.10"

Screen Type	Depth to Bottom - Feet
PVC	125'

DESCRIPTION OF FORMATIONS ENCOUNTERED	FROM	TO	FORMATIONS (Continued)	FROM	TO
Clay	0	20			
Sand	20	60			
Clay	60	105			
Sand	105	125			
Clay	125	140			
			IF MORE SPACE IS NEEDED, USE BACK		

If well telescopes please
sketch and show depths.

GROUND LEVEL

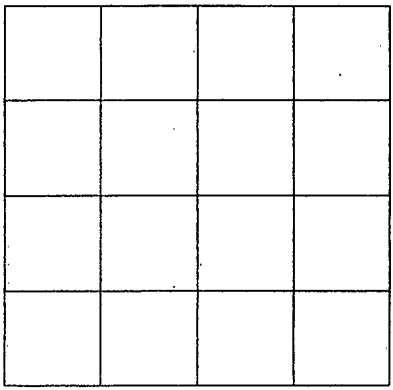

SECTION _____

Please indicate well location X.

ADDITIONAL INFORMATION

If more than one screen,
show location of each on sketch.