LEE
J 18
4-5-61

Date: April 5, 1961, Driller: Ewing Drlg Co. County Lee
(Name) Claude Carnathan (1967 owner)

(1) Owner of Land: Mrs. W. R. Estes
(Name)
Mooreville, Miss.
(Address)

(2) Location: ____ ¼, ____ ¼, Sec. 33 T 9 S R 7 E,

____ miles ____, of ____,
(distance) (direction) (Nearest Town)

(3) Topography: ____
(Hilly) (Flat) (Level)

(4) Purpose of Well: household
(Domestic Irrigation Municipal, Industrial, Other)

Information upon completion of well:

(1) Diameter 4 inches.

(2) Total Depth 308 feet.

(3) Water Level 117 feet below top of ground.

(4) Cased to 35'6", Size ____,

(5) Screen: Size ____, Length ____.

(6) Were any formations sealed against pollution?

✓ yes, ____ no.

If YES depth of formation 35'6",

Why ____

Drillers Remarks: Cylinder

15 P ✓ ELEV 400

Description & Color of Materials Sand, Clay, Red Clay, Shell, etc.	Thickness Feet	Depth Feet
White house		
big pond		
US 78		
.8 mi		
174		
.1 mi		
158 349		
.1 mi		

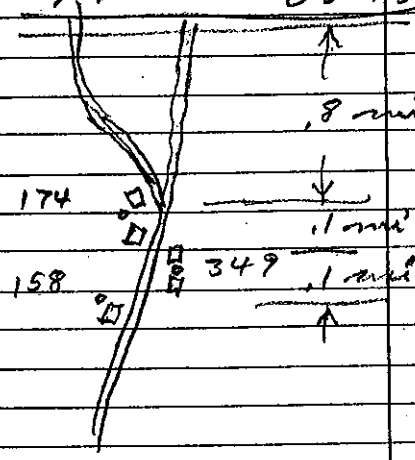

RECEIVED
APR 7 1961
MISS. BOARD OF WATER COMM.

(Use Back Side)

Well No.

Mail this copy to Board of Water Commissioners 429 Miss. St. Jackson, Miss