LeFlore
AA 65
7-3-79

MISSISSIPPI
BOARD OF WATER COMMISSIONERS
416 North State Street
Jackson, Mississippi 39201

WATER WELL DRILLERS LOG

(9)

CODED

7/3 1979 DYER-WELL + IRR LEFLORE
date well completed — firm name — county well located

LANDOWNER: HUGH ARANT

MINTER CITY
(mailing address)

WELL LOCATION:
sec. 29 T 22 (N) S R 2 E (W)
6½ miles N W of MINTER CITY
(distance) (direction) (nearest town)

WELL PURPOSE: (home, irrigation, municipal, industrial)

WELL COMPLETION DATA:

(1) diameter (inches) 16

(2) total depth (feet) 98

(3) static water level (feet) 19 below above top of ground.

(4) casing ~~PE~~ STEEL (material), 58 (depth),
16 (size) if telescope see back.

(5) screen 40 (length), 58 (depth to top)
16 (size), STEEL (material)

(6) pump 40 (HP) 1800 (yield gpm)
DIESEL (type power)

(7) electric log NO (yes or no)

(organization running log)

(8) how well bottom plugged PLATE

DRILLERS REMARKS:

description of formations encountered	from	to
CLAY	0	35
FINE SAND	35	45
SAND	45	55
SAND & GRAVEL	55	98

DEPT. OF NATURAL RESOURCES
BUREAU OF LAND & WATER RESOURCES
NOV 13 1979
RECEIVED

If well telescopes please sketch and show depths.

GROUND LEVEL

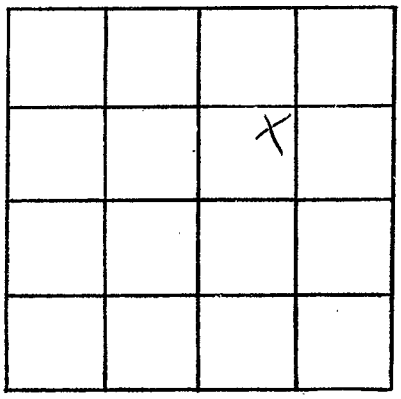

SECTION 29

Please indicate well location X.

ADDITIONAL INFORMATION

If more than one screen, show locations of each on sketch.