LEFLORE
B26
3-16-71

MISSISSIPPI
BOARD OF WATER COMMISSIONERS
416 North State Street
Jackson, Mississippi 39201

CODED

WATER WELL DRILLERS LOG

BUTANE GAS CO. OF GREENWOOD
POST OFFICE BOX 1135
GREENWOOD, MISS. 38930
firm name

3/16/71 19
date well completed

Leflore
county well located

LANDOWNER: W. G. Somerville
Minter City, Miss.
(mailing address)

WELL LOCATION:
sec. 15 T 22 N (S) R 1 E (W)
3 (distance) miles NE (direction) of Minter City (nearest town)

WELL PURPOSE:
(home, irrigation, municipal, industrial)

WELL COMPLETION DATA:

(1) diameter (inches) 2"
(2) total depth (feet) 73
(3) static water level (feet) 18 below above top of ground.
(4) casing Steel (material), 63 (depth), 2" (size) if telescope see back.
(5) screen 10' (length), 63 (depth to top), 2" (size), PVC (material)
(6) pump 1/2 (HP) 10 (yield gpm) Elec. (type power)
(7) electric log No (yes or no)
(organization running log)
(8) how well bottom plugged Back Pressure Valve

DRILLERS REMARKS:

description of formations encountered	from	to
Clay	0	18
Sand	18	73

CODED

MAR 21 1971
MISS. BD. OF WATER COMM.

If well telescopes please sketch and show depths.

GROUND LEVEL

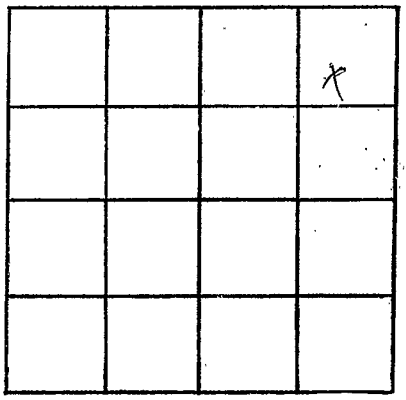

SECTION

Please indicate well location X.

ADDITIONAL INFORMATION

If more than one screen, show locations of each on sketch.