1080

MISSISSIPPI DEPARTMENT OF NATURAL RESOURCES

Bureau of Land and Water Resources

P.O. Box 10631
Jackson, Mississippi 39209

WATER WELL DRILLERS LOG

CODED

COUNTY WELL LOCATED	Leflore
WELL NUMBER	B 77
CODED	
PERMIT NUMBER	TEP 11742 ESD-4-9-89
NAME OF DRILLING FIRM	Dyer Well
DATE WELL COMPLETED	2-24-89

NAME & MAILING ADDRESS OF LANDOWNER

F+G Farms

Box 552

Webb, Ms. 38966

WELL LOCATION: SEC 23 TOWNSHIP 22 (N) S RANGE 1 (E) W

DISTANCE 1 Miles DIRECTION E of NEAREST TOWN Montecatino

OTHER LANDMARK

WELL PURPOSE: Home, (Irrigation) Municipal, Industrial, Fish Pond, etc.

PUMP DATA

PUMP TYPE (Circle One): Submersible, (Turbine,) Jet, Flowing Well, Other (Describe) _____

POWER TYPE (Circle One): Electric, Tractor, (Diesel,) Gasoline, Butane, Other (Describe) _____

Pump Capacity (GPM)	No. of Stages	Setting Depth
1000	3	50 FT.

PUMP TEST

Well yielded _____ GPM with a drawdown of _____ ft. after _____ hours of pumping

WELL DATA

Well Depth	Casing Diameter (In.)	Casing Length (Ft.)
104'	12"	64'

Type of Casing	Hole Depth	Depth to Static Water Level
Iron		

TYPE OF COMPLETION: (Circle One or More): (Gravel Packed) Underreamed, Telescoped, Natural Development, Open Hole, Other (Describe) _____

Top of Lap Pipe or Reduction in Casing FEET

IF TELESCOPED OR MORE THAN ONE SCREEN: USE BACK PAGE

LOG DATA

TYPE OF LOG RUN (Circle One): (No Log Run.) Electric, Gamma Ray, Density, Sonic, Neutron, Other (Describe) _____

Name of Organization Running Log

None

GEOLOGIC DATA (Office Use Only)

Surface Elev.	Geologic Unit	Unit Thickness	Depth to Top
Subs. SWL	Date	Analysis	Aquifer Test

Driller's Remarks

SCREEN DATA

Diameter - Inches	Length - Feet	Slot Size - Inches
16"	40'	.030

Screen Type	Depth to Bottom - Feet
Johnson	

DESCRIPTION OF FORMATIONS ENCOUNTERED	FROM	TO
Clay		
Fine Sand		
Fine Sand + Gravel		
M. Sand + Gravel		

FORMATIONS (Continued)	FROM	TO

RECEIVED
MAR 06 1989
Department of Natural Resources
Bureau of Land & Water Resources

IF MORE SPACE IS NEEDED, USE BACK

If well telescopes please
sketch and show depths.

GROUND LEVEL

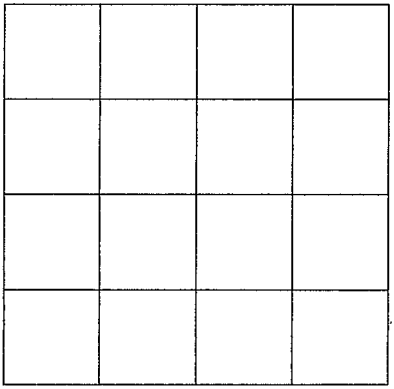

SECTION _____

Please indicate well location X.

ADDITIONAL INFORMATION

If more than one screen,
show location of each on sketch.