MISSISSIPPI DEPARTMENT OF ENVIRONMENTAL QUALITY
Office of Land and Water Resources
P. O. Box 10631
Jackson, MS 39289-0631
WATER WELL DRILLERS LOG

COUNTY WELL LOCATED	Leflore
WELL NUMBER	B84
CODED	
PERMIT NUMBER	GW 38382
NAME OF DRILLING FIRM	Layne-Central, a division of Layne Christensen Company
DATE WELL COMPLETED	10/5/99

NAME & MAILING ADDRESS OF LANDOWNER
Delta Sunrice
c/o Fischer Farm Services
P.O. Box 926
Aberdeen, MS 39730

WELL LOCATION	SEC	TOWNSHIP	RANGE
	5	22 N	1 W

DISTANCE	DIRECTION	NEAREST TOWN
4 Miles	NW of	Minter City

OTHER LANDMARK

WELL PURPOSE: Home, Irrigation, Municipal, Industrial, Fish Pond, etc.

PUMP DATA

PUMP TYPE (Circle One): Submersible, Turbine, Jet, Flowing Well, Other (Describe)

POWER TYPE (Circle One): Electric, Tractor, Diesel, Gasoline, Butane, Other (Describe) H/P

Pump Capacity (GPM)	No. of Stages	Setting Depth
2500	1	60 FT.

PUMP TEST
Well yielded Not Tested GPM with a drawdown of ft. after hours of pumping

WELL DATA

Well Depth	Casing Diameter (In.)	Casing Length (Ft.)
123'	16"	73'

Type of Casing	Hole Depth	Depth to Static Water Level
PVC	123'	24.5'

TYPE OF COMPLETION: (Circle One or More): Gravel Packed, Underreamed, Telescoped, Natural Development, Open Hole, Other (Describe)

WELL GROUTED TO A DEPTH OF 10 FEET
Type Grout (circle one): Cement, Bentonite, or Mix

LOG DATA

TYPE OF LOG RUN (Circle One): No Log Run, Electric, Gamma Ray, Density, Sonic, Neutron, Other (Describe)

Name of Organization Running Log

GEOLOGIC DATA (Office Use Only)

Surface Elev.	Geologic Unit	Unit Thickness	Depth to Top
Subs. SWL	Date	Analysis	Aquifer Test

Driller's Remarks

SCREEN DATA

Diameter - Inches	Length - Feet	Slot Size - Inches
16"	50'	.050

Screen Type	Depth to Bottom - Feet
PVC	123'

Top of Lap Pipe or Reduction in Casing
FEET (IF TELESCOPED OR MORE THAN ONE SCREEN, USE BACK PAGE)

DESCRIPTION OF FORMATIONS ENCOUNTERED	FROM	TO
Clay	0	13
Clay	13	23
Borderline Sand	23	33
Coarse Sand	33	83
Coarse Sand; Clay	83	93
Coarse Sand; Rock	93	123

FORMATIONS (Continued)	FROM	TO

IF MORE SPACE IS NEEDED, USE BACK

MAY 22 2000
Dept. of Environmental Quality
Office of Land & Water Resources

If well telescopes please
sketch and show depths.

GROUND LEVEL

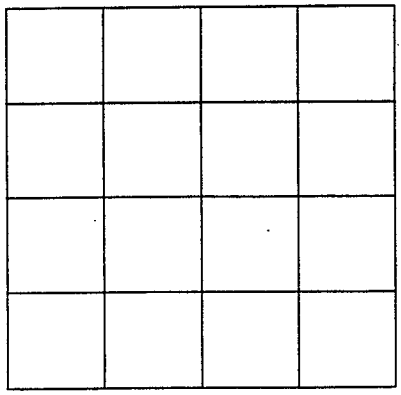

SECTION _____

Please indicate well location X.

ADDITIONAL INFORMATION

If more than one screen,
show location of each on sketch.