MISSISSIPPI DEPARTMENT OF ENVIRONMENTAL QUALITY
Office of Land and Water Resources
P. O. Box 10631
Jackson, MS 39289-0631
WATER WELL DRILLERS LOG

COUNTY WELL LOCATED	Leflore
WELL NUMBER	2
CODED	B 2014
PERMIT NUMBER	
NAME OF DRILLING FIRM	Layne-Central, a division of Layne Christensen Company
DATE WELL COMPLETED	3/9/99

NAME & MAILING ADDRESS OF LANDOWNER
William P. Arnold
1411 Memorial Drive
Boyle, MS 38730

WELL LOCATION:	SEC	TOWNSHIP	RANGE
	18	22 N	1 W

DISTANCE	DIRECTION	NEAREST TOWN
3 Miles	NW	of Minter City

OTHER LANDMARK

WELL PURPOSE: Home, Irrigation, Municipal, Industrial, Fish Pond, etc.
Irrigation

PUMP DATA

PUMP TYPE (Circle One): Submersible, Turbine, Jet, Flowing Well, Other (Describe)

POWER TYPE (Circle One): Electric, Tractor, Diesel, Gasoline, Butane, Other (Describe) H/P

Pump Capacity (GPM)	No. of Stages	Setting Depth
2500	1	60 FT.

PUMP TEST

Well yielded Not Tested GPM with a drawdown of ft. after hours of pumping

WELL DATA

Well Depth	Casing Diameter (In.)	Casing Length (Ft.)
123'	16"	73'

Type of Casing	Hole Depth	Depth to Static Water Level
PVC	123'	25'10"

TYPE OF COMPLETION: (Circle One or More): Gravel Packed, Underreamed, Telescoped, Natural Development, Open Hole, Other (Describe)

WELL GROUTED TO A DEPTH OF 10 FEET
Type Grout (circle one): Cement, Bentonite, or Mix

LOG DATA

TYPE OF LOG RUN (Circle One): No Log Run, Electric, Gamma Ray, Density, Sonic, Neutron, Other (Describe)

Name of Organization Running Log

GEOLOGIC DATA (Office Use Only)

Surface Elev.	Geologic Unit	Unit Thickness	Depth to Top
Subs. SWL	Date	Analysis	Aquifer Test

Driller's Remarks

SCREEN DATA

Diameter - Inches	Length - Feet	Slot Size - Inches
16"	50'	.032

Screen Type	Depth to Bottom - Feet
PVC	123'

Top of Lap Pipe or Reduction in Casing
FEET
IF TELESCOPED OR MORE THAN ONE SCREEN: USE BACK PAGE

DESCRIPTION OF FORMATIONS ENCOUNTERED	FROM	TO
Clay, Fine Sand	0	13
Fine Sand	13	53
Fine Sand, Pea Gravel	53	63
Coarse Sand, Pea Gravel	63	73
Coarse Sand, Pea Gravel	73	123

FORMATIONS (Continued)	FROM	TO

IF MORE SPACE IS NEEDED, USE BACK

RECEIVED
APR 08 1999
Dept. of Environmental Quality
Office of Land & Water Resources

If well telescopes please
sketch and show depths.

GROUND LEVEL

 

If more than one screen,
show location of each on sketch.

SECTION _____

Please indicate well location X.

ADDITIONAL INFORMATION