Leflore Co
D [redacted] 4
7-24-70

MISSISSIPPI
BOARD OF WATER COMMISSIONERS
416 North State Street
Jackson, Mississippi 39201

CODED

WATER WELL DRILLERS LOG

7/24/70 19 BUTANE GAS CO LEFLORE CO
date well completed — firm name — county well located
GREENWOOD MISS

LANDOWNER: BROWN FARMS
SCHLATER MISS
(mailing address)

WELL LOCATION:
sec. 32 T 21 (N) (S) R 1 (E) (W)
1 miles E of SCHLATER
(distance) (direction) (nearest town)

WELL PURPOSE:
(home, irrigation, municipal, industrial)

WELL COMPLETION DATA:
(1) diameter (inches) 6'
(2) total depth (feet) 86
(3) static water level (feet) 17 below ~~above~~ top of ground
(4) casing STEEL (material), 46 (depth),
_____ (size) if telescope see back.
(5) screen 40 (length), 86 (depth to top)
6' (size), STEEL (material)
(6) pump 40 (HP) 800 (yield gpm)
L-P, TRACTOR (type power)
(7) electric log NO (yes or no)
_____ (organization running log)
(8) how well bottom plugged STEEL PLATE.

DRILLERS REMARKS:

description of formations encountered	from	to
CLAY	0	45
SAND	45	60
SAND & GRAVEL	60	86

CODED

JUL 27 1970
MISS. BD. OF
WATER COMM.

If well telescopes please sketch and show depths.

GROUND LEVEL

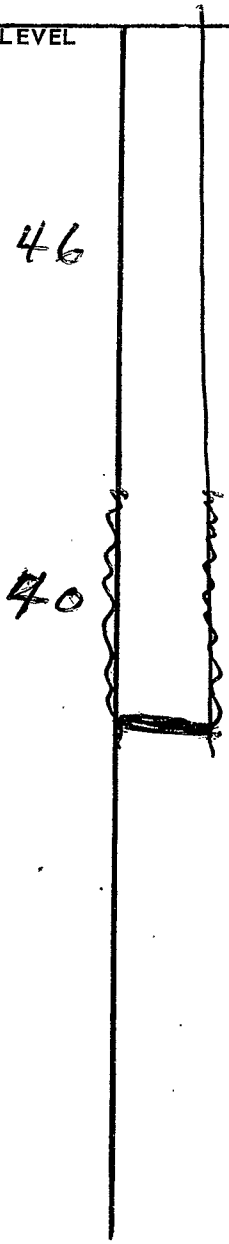

If more than one screen, show locations of each on sketch.

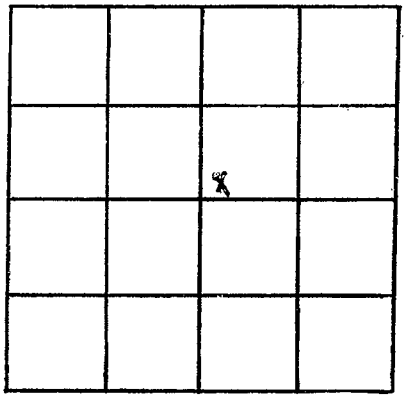

SECTION 32

Please indicate well location X.

ADDITIONAL INFORMATION