

Leflore

D24

11-66

MISSISSIPPI BOARD OF WATER COMMISSIONERS

WATER WELL DRILLERS LOG

CODED

Date: 11-4, 1966, Driller: Butane Gas Co. County: Leflore (Name)

(1) Owner of Land: H. E. Crisp (Name)

Minter City, Miss. (Address)

(2) Location: NW 1/4, NE 1/4, Sec. 7 T21R1W (Location)

4 miles SE SW, of Minter City (distance) (direction) (Nearest Town)

(3) Topography: (Hilly) (Flat) (Level) [checked]

(4) Purpose of Well: Domestic (Domestic Irrigation Municipal, Industrial, Other)

Description & Color of Materials Sand, Clay, Red Clay, Shell, etc.	Thick- ness Feet	Depth Feet
Clay	10	10
Sand + Gravel	120	130
Clay	100	230
Green Sand	120	350
Brown Shale	50	400
Shale	247	647
Brown Shale	83	730
Sand + Shale	130	860
White Sand	60	920

Information upon completion of well:

(1) Diameter 4 3/4 inches.

(2) Total Depth 930 feet.

(3) Water Level flows feet below top of ground.

(4) Cased to 920, Size 4" x 2"

(5) Screen: Size 2", Length 20'

(6) Were any formations sealed against pollution?


yes, [checked] no.

If YES depth of formation

Why

Drillers Remarks:

CODED

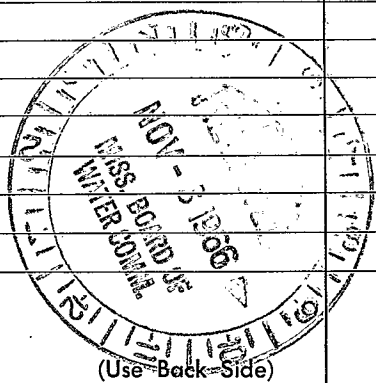

Well No.










