

D 35

4-27-63

WATER WELL DRILLERS LOG

CODED

Date: APRIL 27, 1963, Driller: DELTA DRILLING Co. County LEFLORE

(Name)

(1) Owner of Land: SCHLATER BAPTIST
H.C. MESHANE (Name) CHURCH
SCHLATER MISS
(Address)

(2) Location: NW 1/4, SW 1/4, Sec. 31 T24N R14W
_____ miles _____ of _____
(distance) (direction) (Nearest Town)

(3) Topography: LEVEL
(Hilly) (Flat) (Level)

(4) Purpose of Well: DOMESTIC
(Domestic Irrigation
Municipal, Industrial, Other)

Information upon completion of well:

(1) Diameter 3 inches. W/4" TOP

(2) Total Depth 1119 feet.

(3) Water Level WELL FLOWS feet below top of ground.

(4) Cased to 1097, Size 4" 75'
3" 525'
2" 525'

(5) Screen: Size 2", Length 20'

(6) Were any formations sealed against pollution?
_____ yes, _____ no.


If YES depth of formation _____

Why _____

Drillers Remarks: WELL SET 1117'

28' LAP OF 2" IN 3" PIPE

Description & Color of Materials Sand, Clay, Red Clay, Shell, etc.	Thick- ness Feet	Depth Feet
GUMBO	40	40
SAND	23	63
GRAVEL	83	146
GUMBO	70	216
SAND	42	258
GUMBO CODED	59	317
SAND	40	357
GUMBO	152	509
SAND W/5" ROCK	41	550
GUMBO	22	572
SHALE	85	637
GREEN SAND W/ROCKS	51	688
BROWN SAND	50	738
SHALE	20	758
SAND	20	778
SHALE	100	878
FINE SAND	30	918
GUMBO	10	928
SHALE	50	978
GUMBO	31	1009
SHALE	20	1029
GUMBO	30	1059
SHALE	20	1079
WHITE SAND	40	1119

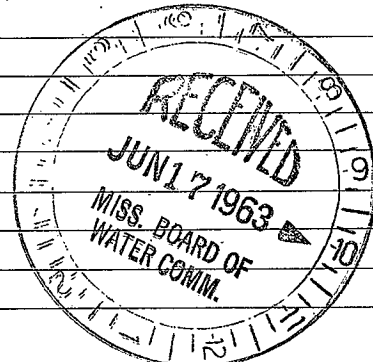

(Use Back Side)

Well No.





