LeFlore
~~C~~ H
2-66

MISSISSIPPI BOARD OF WATER COMMISSIONERS

D192 MS-GW-15523

E LOG #64

WATER WELL DRILLERS LOG

CODED

Date: 2-23-, 1966, Driller: Layne-Central Co. County LeFlore
(Name)

(1) Owner of Land: Schlater Water Assn.
(Name)
Schlater, Mississippi
(Address)

AP 7/07

(2) Location: ~~NW~~ NE ¼, ~~SW~~ SE ¼, Sec. ~~31~~ 36 T 21 N R ~~01~~ 2 W,
_____ miles _____, of _____,
(distance) (direction) (Nearest Town)

(3) Topography: _____
(Hilly) (Flat) (Level)

(4) Purpose of Well: Municipal
(Domestic Irrigation Municipal, Industrial, Other)

Information upon completion of well:

(1) Diameter 8 inches.

(2) Total Depth 1132 feet.

(3) Water Level flowed feet below top of ground.

(4) Cased to 1090', Size 8",

(5) ~~Screen~~: Size 6", Length 40'.

(6) Were any formations sealed against pollution?

x yes, _____ no.

If YES depth of formation 1090',

Why required.

Drillers Remarks: _____

Description & Color of Materials Sand, Clay, Red Clay, Shell, etc.	Thickness Feet	Depth Feet
clay q	30	30
sand-gravel	100	130
shale-stks clay	183	313
sand	67	380
shale-hard stks	75	455
rock	2	457
shale	36	493
rock	1	494
shale-stks rock	96	590
hard shale	10	600
rock	2	602
shale & stks	276	878
sand stks shale	113	991
hard shale-stks rock	49	1040
hard shale-stks sand	50	1090
sand	42	1132
shale-stks rock	120	1252
fine sand-stks shale	81	1333
hard shale	47	1380
rock	3	1383
hard shale-stks rock	65	1448

CODED

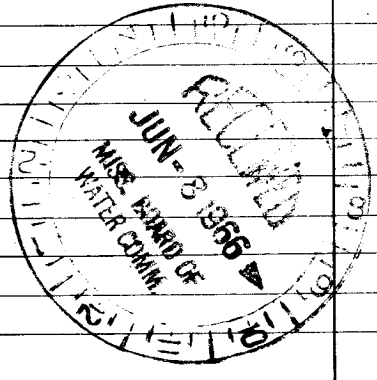

(Use Back Side)

Well No.

Mail this copy to Board of Water Commissioners 429 Miss. St. Jackson, Miss