

GW44876

County: Leflore
 Permit #: GW 44971
 Irrigation Equipment
 Driller: _____
 Date drilling completed: 8-17-11

State Well Report
Part 1 - Driller's Log

Mississippi Department of Environmental Quality
 Office of Land and Water Resources
 P.O. Box 2309
 Jackson, MS 39225
 (601)961-5210
 (601)961-5228 (fax)

For Office Use Only:
 Aquifer: _____
 Well #: E100
 L. S. Elevation: _____
 E-log #: _____

State Law requires that this report be prepared by the license holder responsible for the work and filed with the Department at the above address within 30 days of completion of drilling of the well or borehole.

Information on Well Owner (Landowner if borehole is not for a water well)	Well or Borehole Location
Owner Name: <u>Pleasant View Plantation</u> Mailing Address: <u>4 County Rd 84</u> <u>Greenwood MS 38930</u> City State Zip Code Telephone No. () _____	Latitude: <u>33° 39' 48.9"</u> Longitude: <u>90° 13' 57.3"</u> Method of Lat/Long (circle one): <u>Hand-held GPS</u> Conventional Survey USGS quad: <u>SW 1/4 SE 1/4 Sec 19 Twn 21N Rng 1E</u> Distance Direction Nearest Town <u>1</u> Miles <u>NW</u> of <u>Money</u>

Well / Borehole Data

Date drilling started: 8-17-11 Date drilling completed: 8-17-11 Hole depth: 108 Hole diameter: 24"

Location of the source of any surface water used for drilling: Surface Water
 Method of dosing and volume of Chlorine used in drilling and development: 50 PPM

Logs run (circle all applicable) No log run Electric Gamma Ray Density Sonic Neutron Other: _____
 Name of organization running log(s): _____

Purpose of borehole (check one): Water Well Geotechnical/Geological Investigation _____ Ground Source Heat Pump _____
 Seismic Survey _____ Other (describe) _____

If drilling is not related to water well construction, skip the remainder of this block

Purpose of Well (check one): Home _____ Industrial _____ Public Supply _____ Irrigation _____ Fish Culture Other: _____

If a flowing well, method of flow regulation: Valve _____ Other (describe) _____

Static Water Level: 25 feet above of below (circle one) land surface Date measured: 8-17-11

Method of Measurement (circle one) steel tape electric tape air line other: _____

Well depth: 108 Well grouted to a depth of 10 feet Type of grout (circle one): Neat Cement Bentonite Mix

Casing length: 68 feet Casing diameter: 16 inches Type of casing: PVC

Screen length: 40 feet Screen diameter: 16 inches Type of screen: PVC

Screen slot size: .050 inches Setting depth: From 69 feet to 108 feet

Type of completion (circle all applicable): Gravel packed Underreamed Telescoped Open hole Natural Development
 Other (describe): _____

Top of lap pipe or reduction in casing: _____ feet. *If telescoped or more than one screen, describe on next page*

Applicant: New Hope Farms

Form: OLWR-SWR-1A (04/08)

RECEIVED
 AUG 22 2011
 GW-1000

GW 44876

County: Leflore
 Permit #: GW 44977
 Irrigation Equipment
 Driller: _____
 Date completed: 8-17-11
 Copy information from block on Part 1

STATE WELL REPORT

Part 2

Pump Installer's Completion Report
 Mississippi Department of Environmental Quality
 Office of Land and Water Resources
 P.O. Box 2309
 Jackson, MS 39225
 (601)961-5210
 (601)961-5228 (fax)

For Office Use Only:
 Aquifer: _____
 Well #: E100
 Elevation: _____

This part of the report must be completed by a licensed water well contractor or a licensed pump installer. A copy of Part 1 of the report must be attached and both parts filed with the Department at the above address within 30 days of well completion.


Well Owner Information	Well Location
Pleasant View Plantation Owner Name: _____ Mailing Address: <u>4 County Rd 84</u> <u>Greenwood MS 38930</u> City State Zip Code Telephone No. () _____	Latitude: _____ Longitude: _____ Method of Lat/Long (check one): Conventional Survey _____ USGS quad _____, Hand-held GPS <input checked="" type="checkbox"/> , Survey-grade GPS _____ <u>SW 1/4 SE 1/4 Sec 19 T 21N R 1E</u> Distance Direction Nearest Town <u>1</u> Miles <u>NW</u> of <u>Money</u>

Pump Type	Power Type
Circle one Air Lift <input type="checkbox"/> Jet <input type="checkbox"/> Submersible <input type="checkbox"/> Bucket <input type="checkbox"/> Piston <input type="checkbox"/> <u>Turbine</u> Centrifugal <input type="checkbox"/> Rotary <input type="checkbox"/> Flowing Well <input type="checkbox"/> Other (specify): _____ Date Pump Installed: <u>8-17-11</u> Rated Pump Capacity: <u>2500 ±</u> Gallons Per Minute	Circle one <u>Diesel Engine</u> Gasoline Engine Natural Gas Electric Motor <input checked="" type="checkbox"/> Hand <input type="checkbox"/> Tractor PTO Windmill _____ Other (specify): _____ Horse Power Rating of Motor: <u>60</u> Setting Depth: <u>70</u> feet Number of Stages: <u>1</u>

Pump Test Data	Method of Measuring Water Level
Date Well Tested: _____ Static Water Level (A): _____ Feet Below Land Surface Pumping Water Level (B): _____ Feet Below Land Surface Drawdown [(B) - (A)]: _____ Feet Below Land Surface Test Pumping Rate: _____ Gallons Per Minute Duration of Pump Test (minimum 4 hours): _____ hours	Circle one Air Line Electric Measuring Line Steel Tape Other (specify): _____ For flowing well, measured shut in head: _____ feet Well yielded _____ GPM with a drawdown of _____ feet after _____ hours of pumping

This is for (circle one): New Well Replacement of Existing Pump Repair of Existing Pump

I HEREBY CERTIFY that the above statements are true to the best of my knowledge.
 Patrick M. Chism 0695
 Print Name of Pump Installer and License No. (if applicable) Signature of Pump Installer

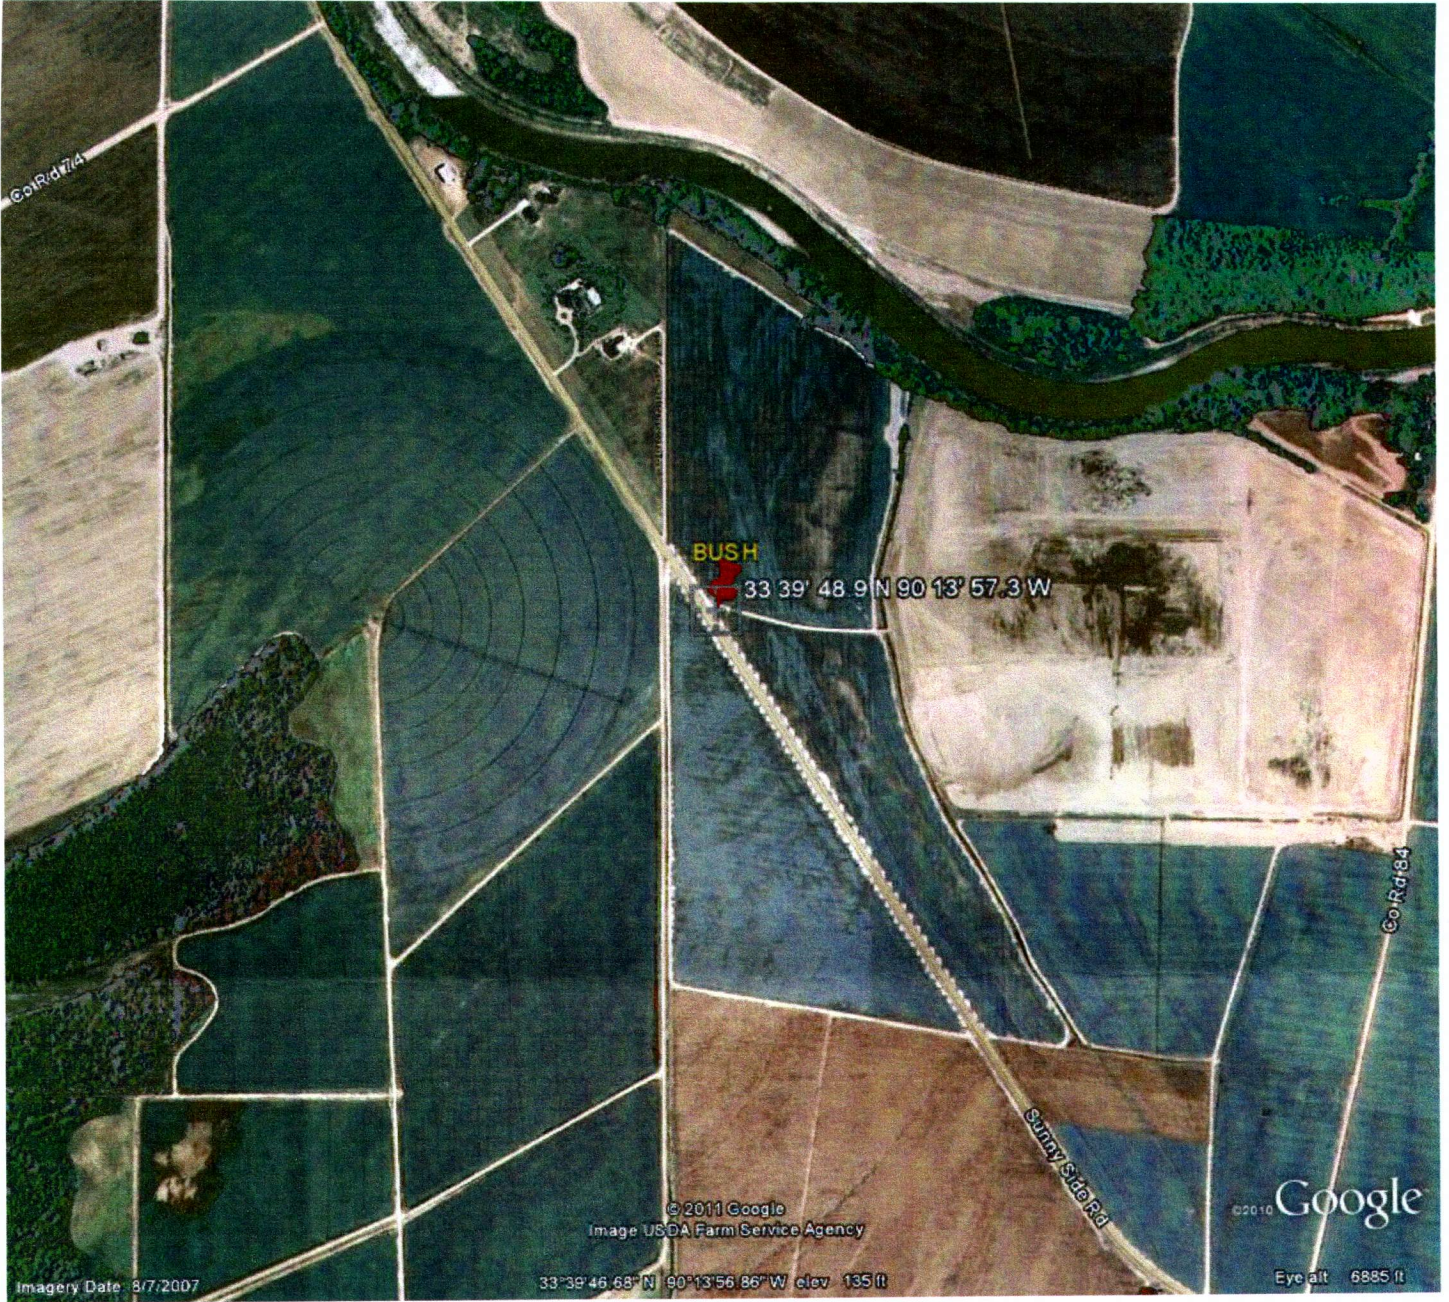

RECEIVED

SEP 06 2011

BY: OLWR