MISSISSIPPI DEPARTMENT OF ENVIRONMENTAL QUALITY
Office of Land and Water Resources

P. O. Box 10631
Jackson, MS 39289-0631
WATER WELL DRILLERS LOG

COUNTY WELL LOCATED: Leflore	
WELL NUMBER: F 2011	CODED:
DATE WELL COMPLETED: 6-2-93	
PERMIT NUMBER:	
NAME OF DRILLING FIRM: IRRIGATION EQUIPMENT 601/887-2555 INDIANOLA, MS	

NAME & MAILING ADDRESS OF LANDOWNER:
F. Hobson Gary Jr.
BOX 69
Schlater, MS 38952

WELL LOCATION: SEC 2 TOWNSHIP 20 (N) S RANGE 2 E (W)

DISTANCE 1 Miles DIRECTION west of NEAREST TOWN schlater

OTHER LANDMARK:

WELL PURPOSE: Home, Irrigation, Municipal, Industrial, Fish Pond, etc.
Irrigation

PUMP DATA

PUMP TYPE (Circle One): Submersible, (Turbine), Jet, Flowing Well, Other (Describe) _____

POWER TYPE (Circle One): Electric, Tractor, (Diesel), Gasoline, Butane, Other (Describe) _____ H/P 60

Pump Capacity (GPM)	No. of Stages	Setting Depth
3000	1	60 FT.

PUMP TEST

Well yielded _____ GPM with a drawdown of _____ ft. after _____ hours of pumping

WELL DATA

Well Depth	Casing Diameter (In.)	Casing Length (Ft.)
115	16	75

Type of Casing	Hole Depth	Depth to Static Water Level
Steel	115	15'

TYPE OF COMPLETION: (Circle One or More): (Gravel Packed), Underreamed, Telescoped, Natural Development, Open Hole, Other (Describe) _____

WELL GROUTED TO A DEPTH OF _____ FEET
Type Grout (circle one): Cement, Bentonite, or Mix

LOG DATA

TYPE OF LOG RUN (Circle One): No Log Run, Electric, Gamma Ray, Density, Sonic, Neutron, Other (Describe) _____

Name of Organization Running Log

GEOLOGIC DATA (Office Use Only)

Surface Elev.	Geologic Unit	Unit Thickness	Depth to Top
Subs. SWL	Date	Analysis	Aquifer Test

Driller's Remarks

SCREEN DATA

Diameter - Inches	Length - Feet	Slot Size - Inches
16	40	.060

Screen Type	Depth to Bottom - Feet
Steel	115

DESCRIPTION OF FORMATIONS ENCOUNTERED	FROM	TO
Clay	0	35
medium sand	35	45
Coarse sand & Gravel	45	85
Coarse sand	85	95
Gravel	95	115

FORMATIONS (Continued)	FROM	TO

RECEIVED
JUN 14 1993
Dept. of Environmental Quality
Office of Land & Water Resources

IF MORE SPACE IS NEEDED, USE BACK

If well telescopes please
sketch and show depths.

GROUND LEVEL

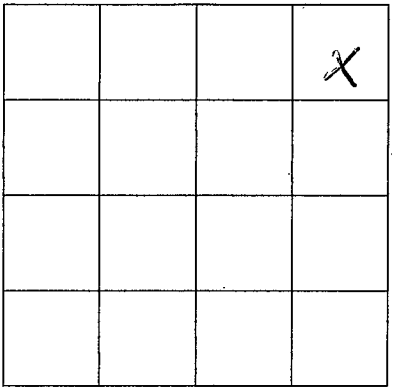

SECTION 2

Please indicate well location X.

ADDITIONAL INFORMATION

If more than one screen,
show location of each on sketch.