MISSISSIPPI DEPARTMENT OF ENVIRONMENTAL QUALITY
Office of Land and Water Resources

P. O. Box 10631
Jackson, MS 39289-0631
WATER WELL DRILLERS LOG

COUNTY WELL LOCATED	Leflore
WELL NUMBER	G 2024
CODED	
DATE WELL COMPLETED	3-23-99
PERMIT NUMBER	
NAME OF DRILLING FIRM	IRRIGATION EQUIPMENT 601/887-2555 INGIANOLA, MS

NAME & MAILING ADDRESS OF LANDOWNER
Tackett Farms
Rt. 1, Box 187
Schlater, MS 38952

WELL LOCATION: SEC 18 TOWNSHIP 20 (N) S RANGE 1 E (W)
NW/SW

DISTANCE 3 Miles DIRECTION South of NEAREST TOWN Schlater

OTHER LANDMARK

WELL PURPOSE: Home, Irrigation, Municipal, Industrial, Fish Pond, etc.
Irrigation

PUMP DATA

PUMP TYPE (Circle One): Submersible, (Turbine), Jet, Flowing Well, Other (Describe) _____

POWER TYPE (Circle One): Electric, Tractor, (Diesel), Gasoline, Butane, Other (Describe) _____ H/P 75

Pump Capacity (GPM)	No. of Stages	Setting Depth
3500 to 4000	1	80 FT.

PUMP TEST

Well yielded _____ GPM with a drawdown of _____ ft. after _____ hours of pumping

WELL DATA

Well Depth	Casing Diameter (In.)	Casing Length (Ft.)
133	16	73

Type of Casing	Hole Depth	Depth to Static Water Level
PVC	133	34 Ft.

TYPE OF COMPLETION: (Circle One or More): (Gravel Packed), Underreamed, Telescoped, Natural Development, Open Hole, Other (Describe) _____

WELL GROUTED TO A DEPTH OF _____ FEET
Type Grout (circle one): Cement, Bentonite, or Mix

LOG DATA

TYPE OF LOG RUN (Circle One): No Log Run, Electric, Gamma Ray, Density, Sonic, Neutron, Other (Describe) _____

Name of Organization Running Log

GEOLOGIC DATA (Office Use Only)

Surface Elev.	Geologic Unit	Unit Thickness	Depth to Top
Subs. SWL	Date	Analysis	Aquifer Test

Driller's Remarks

SCREEN DATA

Diameter - Inches	Length - Feet	Slot Size - Inches
16	60	.050

Screen Type	Depth to Bottom - Feet
PVC	133

Top of Lap Pipe or Reduction in Casing
FEET
IF TELESCOPED OR MORE THAN ONE SCREEN: USE BACK PAGE

DESCRIPTION OF FORMATIONS ENCOUNTERED	FROM	TO
Clay	0	31
Fine Sand	31	50
Fine Sand + Gravel	50	60
med. Sand + Gravel	60	133

FORMATIONS (Continued)	FROM	TO

RECEIVED
APR 05 1999
Dept. of Environmental Quality
Office of Land & Water Resources

IF MORE SPACE IS NEEDED, USE BACK

If well telescopes please
sketch and show depths.

GROUND LEVEL

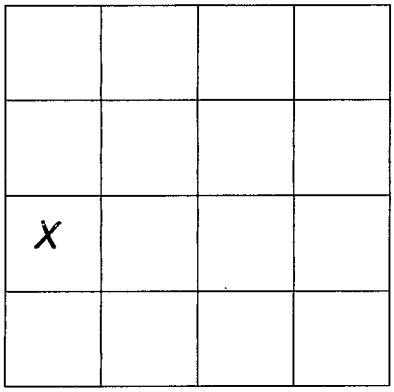

SECTION 18

Please indicate well location X.

ADDITIONAL INFORMATION

If more than one screen,
show location of each on sketch.