LEFORE
H-26
5-68
USGS

MISSISSIPPI
BOARD OF WATER COMMISSIONERS
416 North State Street
Jackson, Mississippi 39201

CODED

WATER WELL DRILLERS LOG

MAY 20, 1968 — date well completed
19 DELTA DRILLING Co. — firm name
LEFLORE — county well located

LANDOWNER: T. Y. GARDNER
GREENWOOD, MISS.
(mailing address)

WELL LOCATION: NW/4 NE/4 SW/4
sec. 21 T 20 N R 1 E
(distance) miles (direction) of (nearest town)

WELL PURPOSE: (home, irrigation, municipal, industrial)

WELL COMPLETION DATA:

(1) diameter (inches) 4"
(2) total depth (feet) 982
(3) static water level (feet) FLOWS below above top of ground.
(4) casing STEEL (material), 715 (depth),
2-3+4" (size) if telescope see back.
(5) screen 20 (length), 715 (depth to top)
2" (size), STAINLESS STEEL (material)
(6) pump 1 (HP) (yield gpm)
ELEC (type power)
(7) electric log YES (yes or no)
U.S.G.S. (organization running log)
(8) how well bottom plugged BACK PRESSURE VALVE

DRILLERS REMARKS: 20' LAP OF 2" IN 3" PIPE.

description of formations encountered	from	to
GUMBO	0	23
SAND	23	75
gravel	75	167
Sand	167	186
gumbo	186	248
Shale	248	310
Sand	310	354
Shale	354	417
Sand	417	479
gumbo	479	508
Sand	508	547
Shale	547	626
Sand	626	665
Shale	665	704
Sand	704	735
gumbo	735	744
Shale	744	803
gumbo	803	822
Shale	822	900
Sand	900	920
Shale	920	959
gumbo	959	982
WELL SET 735'		

CODED
MAY 27 1968
MISS. BOARD OF WATER COM'RS

If well telescopes please sketch and show depths.

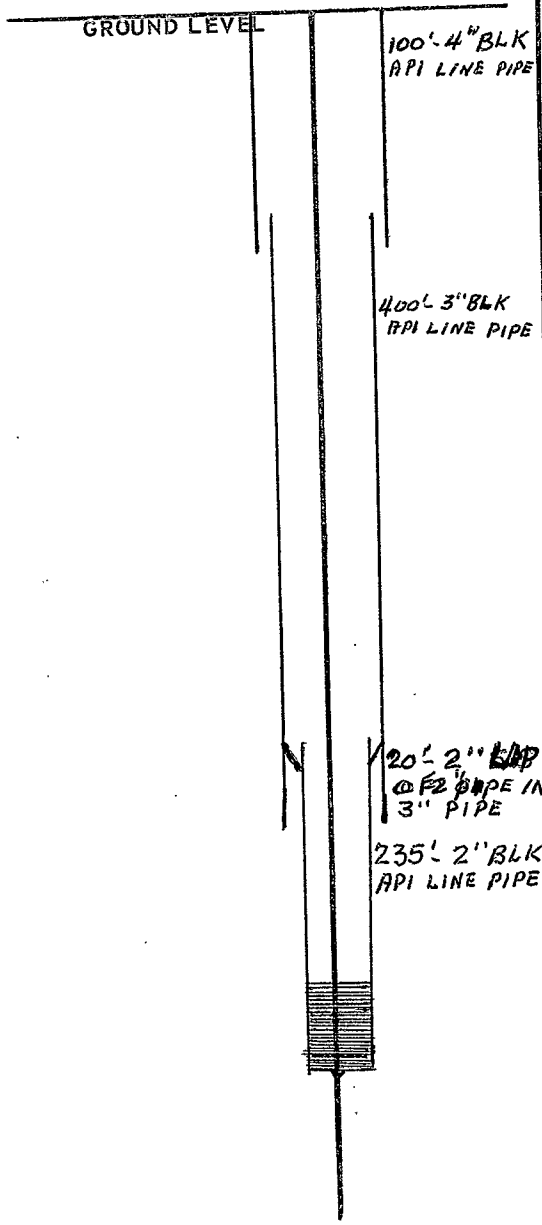

If more than one screen, show locations of each on sketch.

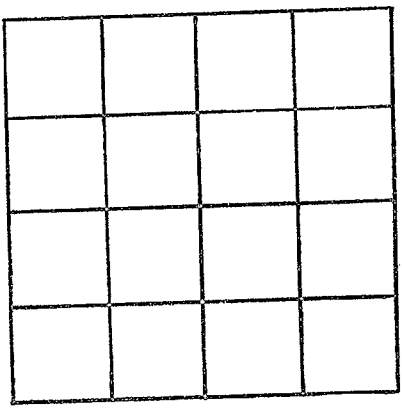

SECTION 21

Please indicate well location X.

ADDITIONAL INFORMATION