MISSISSIPPI DEPARTMENT OF ENVIRONMENTAL QUALITY
Office of Land and Water Resources

P. O. Box 10631
Jackson, MS 39289-0631
WATER WELL DRILLERS LOG

COUNTY WELL LOCATED: LeFlore	
WELL NUMBER: H120	CODED ✓
DATE WELL COMPLETED: 11-96	
PERMIT NUMBER:	
NAME OF DRILLING FIRM: C&S Drilling	

NAME & MAILING ADDRESS OF LANDOWNER
Floyd Peoples
R.T. I, Box 42
Greenwood, MS

WELL LOCATION: SEC 20 TOWNSHIP T20 N ~~S~~ RANGE R2 E ~~W~~

DISTANCE 7 Miles DIRECTION N of NEAREST TOWN Greenwood

OTHER LANDMARK

WELL PURPOSE: (Home) Irrigation, Municipal, Industrial, Fish Pond, etc.

PUMP DATA

PUMP TYPE (Circle One): (Submersible) Turbine, Jet Flowing Well, Other (Describe)

POWER TYPE (Circle One): (Electric) Tractor, Diesel, Gasoline, Butane, Other (Describe) H/P

Pump Capacity (GPM)	No. of Stages	Setting Depth
18	9	63 FT.

PUMP TEST

Well yielded _____ GPM with a drawdown of _____ ft. after _____ hours of pumping

WELL DATA

Well Depth	Casing Diameter (In.)	Casing Length (Ft.)
578	4	558

Type of Casing	Hole Depth	Depth to Static Water Level
PVC	580	1

TYPE OF COMPLETION: (Circle One or More): Gravel Packed, Underreamed, Telescoped, (Natural Development) Open Hole, Other (Describe)

WELL GROUTED TO A DEPTH OF 10 FEET
Type Grout (circle one): Cement, Bentonite, or Mix

LOG DATA

TYPE OF LOG RUN (Circle One): (No Log Run) Electric, Gamma Ray, Density, Sonic, Neutron, Other (Describe)

Name of Organization Running Log

GEOLOGIC DATA (Office Use Only)

Surface Elev.	Geologic Unit	Unit Thickness	Depth to Top
Subs. SWL	Date	Analysis	Aquifer Test

Driller's Remarks

SCREEN DATA

Diameter - Inches	Length - Feet	Slot Size - Inches
4	20	.010

Screen Type	Depth to Bottom - Feet
PVC	578

DESCRIPTION OF FORMATIONS ENCOUNTERED	FROM	TO
Top Soil & Clay	0	18
Sand	18	61
Sand & Gravel	61	112
Clay	112	141
Sand & Rocks	141	284
Shell & Rocks	284	468
Shell	468	539
Sand	539	580

FORMATIONS (Continued)	FROM	TO

RECEIVED
MAR 06 1997
Dept. of Environmental Quality
Office of Land & Water Resources

IF MORE SPACE IS NEEDED, USE BACK

If well telescopes please
sketch and show depths.

GROUND LEVEL

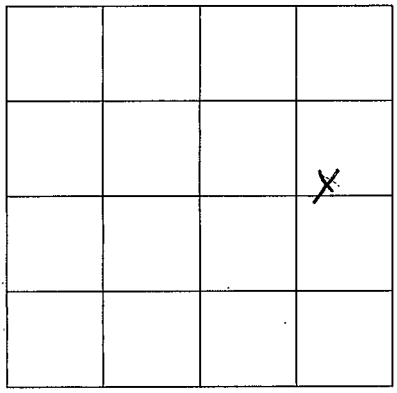

SECTION 20

Please indicate well location X.

ADDITIONAL INFORMATION

If more than one screen,
show location of each on sketch.