

STATE WELL REPORT

124

 Date drilling completed: 6/7/18

Part 1
Driller's Log
 Mississippi Department of Environmental Quality
 Office of Land and Water Resources
 P.O. Box 2309
 Jackson, MS 39225-2309
 (601)961-5555
 (601)961-5228 (fax)

For Office Use Only:

Well #: H 183
 Aquifer: _____
 E-Log #: _____

State Law requires that this report be prepared by the license holder responsible for the work and filed with the Department at the above address within 30 days of completion of drilling of the well or borehole.

Well Owner Information <small>(Landowner if borehole is not for a water well)</small>	Well or Borehole Location
Owner Name: <u>Joe R. Ross</u>	Latitude: <u>33 35 52</u> Longitude: <u>90 07 09</u>
Mailing Address: <u>1200 Meadowbrook Rd. Apt 37</u>	Method of Lat/Long (check one): Conventional Survey _____
<u>Jackson</u> MS <u>39206</u>	USGS quad _____, Hand-held GPS <u>N</u> , Survey-grade GPS _____
City State Zip Code	<u>SE</u> 1/4 <u>NE</u> 1/4, Sec <u>18</u> T <u>20N</u> R <u>02E</u>
Telephone No. (____) _____	<u>7</u> Miles <u>N</u> of <u>Greenwood</u>
	(Distance) (Direction) (Nearest Town)

Well / Borehole Data

Date drilling started: 6/7/18 Date drilling completed: 6/7/18 Hole depth: 110 Hole diameter: 24

Location of the source of any surface water used for drilling: Ditch

Method of dosing and volume of Chlorine used in drilling and development: _____

Logs run (check all applicable): Log run Electric Gamma Ray Density Sonic Neutron Other: _____

Name of organization running log(s): _____

Purpose of borehole (check one): Water Well Geotechnical/Geological Investigation Ground Source Heat Pump Seismic Survey Other (describe) _____

If drilling is not related to water well construction, skip the remainder of this block

Purpose of Well (check all applicable): Home Industrial Public Supply Irrigation Fish Culture

Other (describe): _____

If a flowing well, method of flow regulation: Valve _____ Other (describe) _____

Static Water Level: 12 feet above or below land surface Date measured: 6/8/18

(check one)

Method of measurement (check one) Steel tape Electric tape Air line Other (describe): _____

Well depth: 110 Well grouted to a depth of: 10 feet Type of grout (check one) Neat Cement Bentonite Mix

Casing length: 70 feet Casing diameter: 14 inches Type of casing: PVC

Screen length: 40 feet Screen diameter: 16 inches Type of screen: PVC

Screen slot size: .032 inches Setting depth: From 70 feet to 110 feet

Type of completion (check all applicable) Gravel packed Underreamed Open hole Natural Development

Other (describe): _____

Top of lap pipe or reduction in casing: _____ feet

If telescoped or more than one screen, describe on next page

STATE WELL REPORT

Part 2

Pump Installer's Completion Report
 Mississippi Department of Environmental Quality
 Office of Land and Water Resources
 P.O. Box 2309
 Jackson, MS 39225-2309
 (601)961-5210
 (601) 360-0535 (fax)

For Office Use Only:

Well #: H 183

Aquifer: _____

County: LeFlore
 Permit #: MS-LW-50481
 Driller: Chad McPherson
 Date completed: 6/8/18
Copy information from block on Part 1

This part of the report must be completed by a licensed water well contractor or a licensed pump installer. A copy of Part 1 of the report must be attached and both parts filed with the Department at the above address within 30 days of well completion.

Well Owner Information	Well Location
Owner Name: <u>Joe R. Ross</u>	Latitude: <u>33 35 52</u> Longitude: <u>90 07 09</u>
Mailing Address: _____	Method of Lat/Long (check one): Conventional Survey _____
<u>1200 Meadowsbrook Rd</u>	USGS quad _____, Hand-held GPS <u>N</u> , Survey-grade GPS _____
<u>Jackson</u> <u>MS</u> <u>39206</u>	<u>SE</u> ¼ <u>NE</u> ¼, Sec <u>18</u> T <u>20N</u> R <u>02E</u>
City State Zip Code	<u>7</u> Miles <u>N</u> of <u>Greenwood</u>
Telephone No. (____) _____	(Distance) (Direction) (Nearest Town)

Pump Type (check one)

Submersible Turbine Air Lift Centrifugal Flowing Well Jet Piston Rotary Other (describe): _____

Date Pump Installed: 6/8/18 Rated Pump Capacity: 2500 Gallons Per Minute

Is This Pump (check one): New Repaired Replacement

Power Type (check one)

Electric Diesel Gasoline Natural Gas Tractor PTO Windmill Other (describe): _____

Horse Power Rating of Motor: 60 Setting Depth: 70 feet Number of Stages: 2

Pump Test Data for Non Flowing Well

Date Well Tested: _____ Duration of Pump Test (minimum 4 hours): _____ hours

Static Water Level (A): _____ Feet Below Land Surface Pumping Water Level (B): _____ Feet Below Land Surface

Drawdown [(B) - (A)]: _____ Feet Below Land Surface Test Pumping Rate: _____ Gallons Per Minute

Method of measurement (check one): Steel tape Electric tape Air line Other (describe): _____

Pump Test Data for Flowing Well

Measured shut in head: _____ feet.

Well yielded _____ GPM with a drawdown of _____ feet after _____ hours of pumping

Meter Installation

Meter Manufacturer: _____ Meter Serial Number: _____

Meter Model Number/Name: _____ Type of Meter: _____

Totalizer Register Unit and Multiplier Factor (AF x .001, gal x 1000, etc): _____


Installation Date: _____ Meter installed by: _____


Is This Meter (check one): New Repaired Replacement

Important: By submitting the above information you are certifying that this meter was installed to manufacturer standards. For agricultural wells, a list of approved meters is on the MDEQ website.

I HEREBY CERTIFY that the above statements are true to the best of my knowledge

Chad B McPherson UNR-8243 11/1/19 Chad B McPherson
 Print Name of Pump Installer and License No. (if applicable) Date Signature of Pump Installer

 

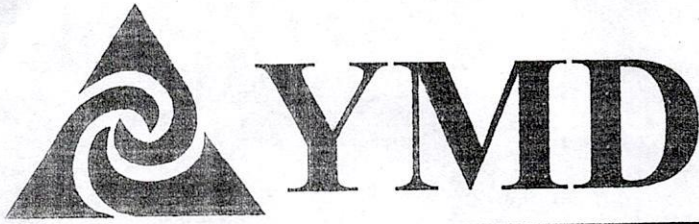

Don R. Christy, PhD
Executive Director
P. O. Box 129
Stoneville, MS 38776
Tel.: (662) 686-7712
Fax: (662) 686-9078
www.ymd.org

Yazoo Mississippi Delta Joint Water Management District

June 7, 2018

Joe R. Ross
1200 Meadowbrook Road, Apt. 37
Jackson, MS 39206

RE: Receipt for Notification of Construction of Replacement Well **MS-GW-50481**
which will be replacing MS-GW-36805 located at
Location: SE ¼ of the NE ¼ Section 18 Township 20N Range 02E County Leflore
Latitude: 333548 Longitude: 900709

Dear Joe R. Ross,

This letter acknowledges your notification to the state that you intend to replace a previously permitted well in the Mississippi River Valley Alluvial Aquifer and that this replacement construction will meet the requirements for a groundwater replacement well specified in 11 Miss. Admin. Code Part 7, Chapter 1, Rule 1.4.F.1 (). Construction may begin immediately on your replacement well.

Remember that you are still required to submit a permit application (enclosed) for the replacement well within 5 days of construction beginning. You are also required to properly decommission (plug and abandon) the replaced well within 180 days of the replacement well's construction.

A copy of this letter, or a water use permit for the replacement well, **must** be attached to the State Well Report submitted by your driller to MDEQ and they must also submit a copy to YMD, as specified in the Water Well Contractor regulations found in 11 Miss. Admin. Code Part 7, Chapter 2, Rule 2.9.

If you have any questions, please call YMD at 662-686-7712.

Sincerely,

Dillard Melton Jr.

Dillard Melton Jr.
Permitting Director

Replacement well requirements

11 Miss. Admin. Code Part 7, Chapter 1, Rule 1.4.F.1.

F. Replacement Wells - A replacement well may be drilled to replace a properly authorized well that has become unusable.

(1) Qualifications - To qualify as a replacement well for any use other than irrigation, aquaculture, or wildlife enhancement the new well must meet all of the requirements set forth in paragraphs a. through d. below. Any proposed well not meeting these requirements will be treated as a new well, and the required application will be processed accordingly. Replacement wells for irrigation, aquaculture, or wildlife enhancement need only meet the requirements set forth in 24 paragraphs (a) through (c) below provided the water will be applied to the same field or pond served by the original well.

- (a) Will replace a well that will be properly plugged and abandoned within 180 days of completion of the replacement well, unless used by MDEQ for data collection in accordance with paragraph 3 below; and
- (b) Will withdraw water from the same water-bearing formation as the old well; and
- (c) Will supply water for the same beneficial use as the old well