CODED

MISSISSIPPI DEPARTMENT OF NATURAL RESOURCES

Bureau of Land and Water Resources

P.O. Box 10631
Jackson, Mississippi 39209

WATER WELL DRILLERS LOG

COUNTY WELL LOCATED: LeFlore	
WELL NUMBER: 107	CODED
PERMIT NUMBER: 8075	
NAME OF DRILLING FIRM: J & K Irrigation	
DATE WELL COMPLETED: 8-16-88	

NAME & MAILING ADDRESS OF LANDOWNER
Steve Scott
Itta Bena, Miss

WELL LOCATION: SEC 15 TOWNSHIP 19 N RANGE 2 W

DISTANCE 5 Miles DIRECTION N of NEAREST TOWN Itta Bena

OTHER LANDMARK

WELL PURPOSE: Home, Irrigation, Municipal, Industrial, Fish Pond, etc.

PUMP DATA

PUMP TYPE (Circle One): Submersible, Turbine, Jet, Flowing Well, Other (Describe)

POWER TYPE (Circle One): Electric, Tractor, Diesel, Gasoline, Butane, Other (Describe)

Pump Capacity (GPM)	No. of Stages	Setting Depth
2400	2	60 FT.

PUMP TEST

Well yielded 2400 GPM with a drawdown of 23 ft. after _____ hours of pumping

WELL DATA

Well Depth	Casing Diameter (In.)	Casing Length (Ft.)
119	16"	79

Type of Casing	Hole Depth	Depth to Static Water Level
Steel	119	34

TYPE OF COMPLETION: (Circle One or More): Gravel Packed, Underreamed, Telescoped, Natural Development, Open Hole, Other (Describe)

Top of Lap Pipe or Reduction in Casing FEET

IF TELESCOPED OR MORE THAN ONE SCREEN: USE BACK PAGE

LOG DATA

TYPE OF LOG RUN (Circle One): No Log Run, Electric, Gamma Ray, Density, Sonic, Neutron, Other (Describe)

Name of Organization Running Log

GEOLOGIC DATA (Office Use Only)

Surface Elev.	Geologic Unit	Unit Thickness	Depth to Top
Subs. SWL	Date	Analysis	Aquifer Test

Driller's Remarks

SCREEN DATA

Diameter - Inches	Length - Feet	Slot Size - Inches
16	40	.030

Screen Type	Depth to Bottom - Feet
Steell	119

RECEIVED
SEP 14 1988
Department of Natural Resources
Bureau of Land & Water Resources

DESCRIPTION OF FORMATIONS ENCOUNTERED	FROM	TO
Clay	0	19
Fine Sand	19	41
Sand & Gravel	41	119

FORMATIONS (Continued)	FROM	TO

IF MORE SPACE IS NEEDED, USE BACK

If well telescopes please
sketch and show depths.

GROUND LEVEL

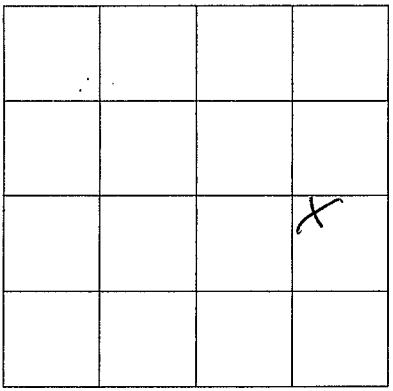

SECTION 15

Please indicate well location X.

ADDITIONAL INFORMATION

If more than one screen,
show location of each on sketch.