MISSISSIPPI DEPARTMENT OF NATURAL RESOURCES

Bureau of Land and Water Resources

P.O. Box 10631
Jackson, Mississippi 39209

WATER WELL DRILLERS LOG

CODED

COUNTY WELL LOCATED	LeFlore
WELL NUMBER	F 112
CODED	
DATE WELL COMPLETED	5-29-90
PERMIT NUMBER	148 A
NAME OF DRILLING FIRM	J & K Drillers

NAME & MAILING ADDRESS OF LANDOWNER
Paul Battle Farms
Rt. 1, Box 180
Tunica, Ms. 38676

WELL LOCATION: SEC 32 TOWNSHIP 19 N ~~S~~ RANGE 2 E ~~W~~

DISTANCE ½ Miles DIRECTION E NEAREST TOWN of Colony Town

OTHER LANDMARK

WELL PURPOSE: Home, Irrigation, Municipal, Industrial, Fish Pond, etc.
Irrigation

PUMP DATA

PUMP TYPE (Circle One): Submersible, Turbine, Jet Flowing Well, Other (Describe) _____

POWER TYPE (Circle One): Electric, Tractor, Diesel, Gasoline, Butane, Other (Describe) _____

Pump Capacity (GPM)	No. of Stages	Setting Depth
900	1	60 FT.

PUMP TEST

Well yielded 900 GPM with a drawdown of 52 ft. after _____ hours of pumping

WELL DATA

Well Depth	Casing Diameter (In.)	Casing Length (Ft.)
119	10	79

Type of Casing	Hole Depth	Depth to Static Water Level
PVC	120	26

TYPE OF COMPLETION: (Circle One or More): Gravel Packed, Underreamed, Telescoped, Natural Development, Open Hole, Other (Describe) _____

Top of Lap Pipe or Reduction in Casing FEET

IF TELESCOPED OR MORE THAN ONE SCREEN: USE BACK PAGE

LOG DATA

TYPE OF LOG RUN (Circle One): No Log Run, Electric, Gamma Ray, Density, Sonic, Neutron, Other (Describe) _____

Name of Organization Running Log

GEOLOGIC DATA (Office Use Only)

Surface Elev.	Geologic Unit	Unit Thickness	Depth to Top
Subs. SWL	Date	Analysis	Aquifer Test

Driller's Remarks

SCREEN DATA

Diameter - Inches	Length - Feet	Slot Size - Inches
10	40	.050

Screen Type	Depth to Bottom - Feet
PVC	119

DESCRIPTION OF FORMATIONS ENCOUNTERED	FROM	TO
Topsoil & Clay	0	18
Fine Sand	18	31
Coarse Sand	31	52
Sand & Gravel	52	120

FORMATIONS (Continued) FROM TO

IF MORE SPACE IS NEEDED, USE BACK

RECEIVED
JUN 04 1990
Department of Natural Resources
Bureau of Land & Water Resources

If well telescopes please
sketch and show depths.

GROUND LEVEL

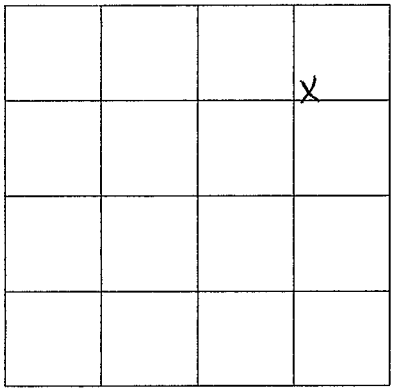

SECTION 32

Please indicate well location X.

ADDITIONAL INFORMATION

If more than one screen,
show location of each on sketch.