MISSISSIPPI DEPARTMENT OF ENVIRONMENTAL QUALITY
Bureau of Land and Water Resources

P. O. Box 10631
Jackson, MS 39289-0631
WATER WELL DRILLERS LOG

COUNTY WELL LOCATED	
Leflore	
WELL NUMBER	CODED
Site-6 Well-2	✓
LE-J702 J 19	
DATE WELL COMPLETED	
5/4/94	

PERMIT NUMBER
NAME OF DRILLING FIRM
Layne-Central

NAME & MAILING ADDRESS OF LANDOWNER

Steve Scott

Route 1, Box 172

Itta Bena, MS 38941

WELL LOCATION: SEC	TOWNSHIP	RANGE
9	T19 (N) S	R2 E (W)

DISTANCE	DIRECTION	NEAREST TOWN
Miles	of	

OTHER LANDMARK

WELL PURPOSE: Home, (Irrigation), Municipal, Industrial, Fish Pond, etc.

PUMP DATA

N/A

PUMP TYPE (Circle One): Submersible, Turbine, Jet, Flowing Well, Other (Describe) _____

POWER TYPE (Circle One): Electric, Tractor, Diesel, Gasoline, Butane, Other (Describe) _____ H/P _____

Pump Capacity (GPM)	No. of Stages	Setting Depth
		FT.

PUMP TEST

Well yielded _____ GPM with a drawdown of _____ ft. after _____ hours of pumping

WELL DATA

Well Depth	Casing Diameter (In.)	Casing Length (Ft.)
172'	6"x4"	162'
Type of Casing	**Hole Depth**	**Depth to Static Water Level**
PVC	184'	

TYPE OF COMPLETION: (Circle One or More): (Gravel Packed), Underreamed, Telescoped, Natural Development, Open Hole, Other (Describe) _____

Top of Lap Pipe or Reduction in Casing: 6 FEET

IF TELESCOPED OR MORE THAN ONE SCREEN: USE BACK PAGE

LOG DATA

TYPE OF LOG RUN (Circle One): No Log Run, (Electric), Gamma Ray, Density, Sonic, Neutron, Other (Describe) _____

Name of Organization Running Log: State

GEOLOGIC DATA (Office Use Only)

Surface Elev.	Geologic Unit	Unit Thickness	Depth to Top
Subs. SWL	Date	Analysis	Aquifer Test

Driller's Remarks

SCREEN DATA

Diameter - Inches	Length - Feet	Slot Size - Inches
4"	10'	.010"
Screen Type	**Depth to Bottom - Feet**	
PVC	175'	

DESCRIPTION OF FORMATIONS ENCOUNTERED	FROM	TO
Clay	0	36
Sand	36	51
Coarse Sand	51	65
Cor. Sand & Pee Gravel	65	93
Cor. Sand & Gravel	93	103
Clay	103	108
Sand & Pee Gravel	108	140
Sand & Clay Streak	140	164
Sand	164	184

FORMATIONS (Continued)	FROM	TO

IF MORE SPACE IS NEEDED, USE BACK

RECEIVED
JUL 25 1994
Dept. of Environmental Quality
Office of Land & Water Resources

If well telescopes please
sketch and show depths.

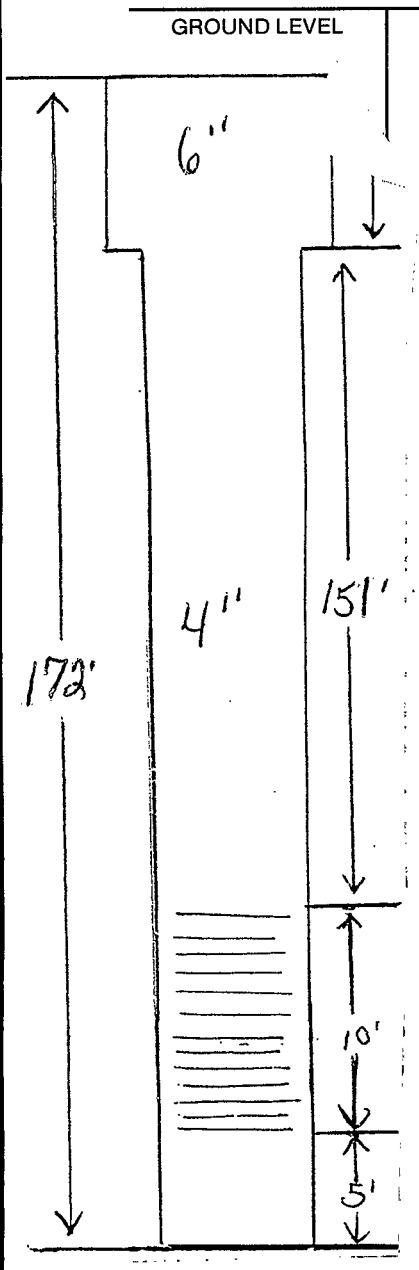

If more than one screen,
show location of each on sketch.

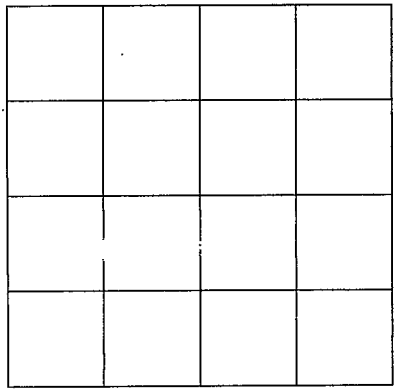

SECTION _____

Please indicate well location X.

ADDITIONAL INFORMATION