K66
LEFLORE
8-8-83

MISSISSIPPI DEPARTMENT OF NATURAL RESOURCES

Bureau of Land and Water Resources
Southport Mall
P.O. Box 10631
Jackson, Mississippi 39209

CODED

WATER WELL DRILLERS LOG

BUTANE GAS COMPANY
~~OF GREENWOOD~~

8-8 19 83 — date well completed
firm name
Leflore — county well located

LANDOWNER: Prestidge
Ralph Prestidge
Ittabena
(mailing address)

WELL LOCATION:
sec. 25 T 19 (N) S R 1 (W)
6.5 miles NW of Ittabena
(distance) (direction) (nearest town)

WELL PURPOSE:
(home, irrigation, municipal, industrial)

WELL COMPLETION DATA:

(1) diameter (inches) 16"
(2) total depth (feet) 95
(3) static water level (feet) 15 (below) above top of ground.
(4) casing Steel (material), 65' (depth),
16" (size) if telescope see back.
(5) screen 40 (length), 65' (depth to top)
16" (size), Steel (material)
(6) pump 30 (HP) 2000 (yield gpm)
Electric (type power)
(7) electric log No (yes or no)
No (organization running log)
(8) how well bottom plugged Steel plate

DRILLERS REMARKS: Carlos Ramos

description of formations encountered	from	to
Clay	0	50
Sand & gravel	50	95

CODED

DEPT. OF NATURAL RESOURCES
BUREAU OF LAND & WATER RESOURCES
AUG 12 1983
RECEIVED

If well telescopes please sketch and show depths.

GROUND LEVEL

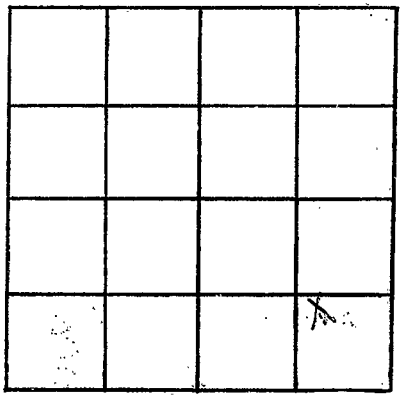

SECTION 25

Please indicate well location X.

ADDITIONAL INFORMATION

If more than one screen, show locations of each on sketch.