LEFLORE
L 43
9-25-73

MISSISSIPPI
BOARD OF WATER COMMISSIONERS
416 North State Street
Jackson, Mississippi 39201

CODED

WATER WELL DRILLERS LOG

Sept 25 19 73 Delta Drilling Leflore
date well completed firm name county well located

LANDOWNER: Mr. C. G. Hull
501 Pearl St.
Greenwood, Miss.
(mailing address)

WELL LOCATION:
sec. 8 T 19 (N) S R 1 (E) W
½ (distance) miles W (direction) of Greenwood (nearest town)

WELL PURPOSE:
(home), irrigation, municipal, industrial)

WELL COMPLETION DATA:
(1) diameter (inches) 4 X 2
(2) total depth (feet) 854
(3) static water level (feet) 20 (below) above top of ground.
(4) casing Steel (material), _____ (depth),
_____ (size) if telescope see back.
(5) screen 20' (length), 830 (depth to top)
2" (size), S.S. (material)
(6) pump 1 (HP) _____ (yield gpm)
Elec. (type power)
(7) electric log NO (yes or no)
_____ (organization running log)
(8) how well bottom plugged BACK PRESSURE VALVE

DRILLERS REMARKS:

description of formations encountered	from	to
Top Soil	0	17
Clay	17	36
Gravel	36	118
Sand	118	261
Gumbo	261	329
Shale	329	347
Sand	347	393
Gumbo	393	409
Sand	409	458
Shale	458	464
Sand w-4" Rock	464	502
Shale w-4" Rock	502	524
Sand	524	572
Shale	572	590
Gumbo	590	614
Shale	614	624
Sand	624	638
Gumbo	638	688
Sand	688	729
Gumbo	729	782
Sand	782	854

CODED

OCT 25 1973
MISS. BD. OF WATER COMM.

If well telescopes please sketch and show depths.

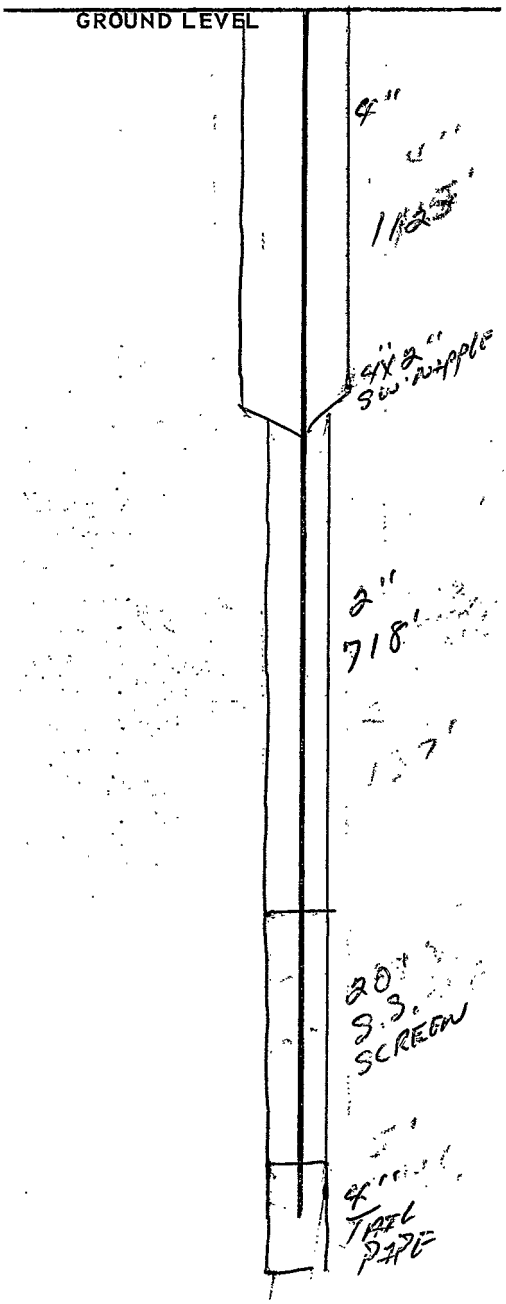

If more than one screen, show locations of each on sketch.

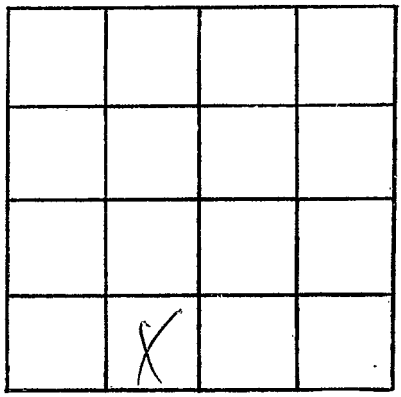

SECTION 8

Please indicate well location X.

ADDITIONAL INFORMATION